

KANSASSection 1 Township 10 Range 21WWell No. 1 MuilengerCompany D.G. HansonMoran
NORTH

							D

WEST

EAST

SOUTH

Graham KANSAS

Sec. 1 Twp. 10 R. 21W

Well No. #1 Muilenger Farm

D. G. Hanson Company

Moran Pool


990' Ft. from N. Line

 Ft. from S. Line

330' Ft. from E. Line

 Ft. from W. Line

SE NE SE

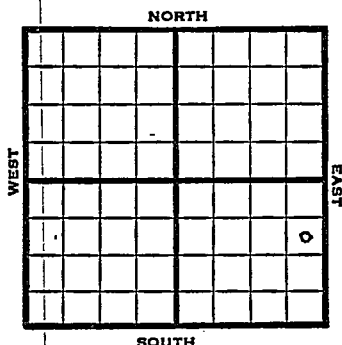

1949

Elev 2247' REPORT

5/25	Location	
6/1	8" @ 187'	
	Drlg 2815'	
6/7	Lansing 3534'	Arbuckle 3839'
	TD 3841'	
	5" @ 3839'	
6/15	"	
6/21	TD 3842'	
	500 acid 1035' oil	
6/28	"	
7/6	"	
7/12	"	
7/28	"	
7/27	TD 3862'	
	500 acid	
	Pump 11 bbls oil PH 8 hrs.	
8/3	"	
8/10	"	
8/17	"	
8/24	"	
8/31	TD 3842'	
	Arb. 3839'	
	5" @ 3839'	
	500 acid	
	Pump 155 Oil Pot	
	290 Gr.	
	Comp	

COMPLETED

Map No. _____ Sec. 1 Twp. 10 R. 21W

Well No. 1 Mullenger

D. G. Hanson Company

Contractor

SE NE SE

FIRST REPORT
SECTION PLAT

990 Ft. from N. Line

_____ Ft. from S. Line

330 Ft. from E. Line

_____ Ft. from W. Line

Graham County

Location X

Rig up _____

Drilling and Remarks:

RECORD

Cased _____ in., _____ ft.

Sand _____

Gas _____

Oil _____

Total Depth _____

PRODUCTION

1st 24 hrs. Nat. _____

1st 24 hrs. after shot _____

Gas _____ Cu. Ft.

Dry Hole _____

Abandoned _____

Date

MAY 25 1949 19

S. J. LEWIS Scout

Kansas

Map No. K65 Sec. 1 Twp. 10 R. 21WWell No. 1 Muilenger

D. G. Hansen

Company

COMPLETE

Contractor


SE NE SE

212242
SECTION PLAT990 Ft. from N. Line

Ft. from S. Line

330 Ft. from E. Line

Ft. from W. Line

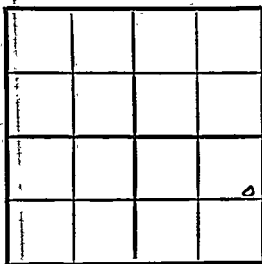

Graham County

RECORD

Location

Cased _____ in., _____ ft.

Rig up

Sand _____

Drilling and Remarks:

Gas _____

Oil _____

Total Depth 2542

PRODUCTION

1st 24 hrs. Nat. _____

1st 24 hrs. after shot _____

Gas _____ Cu. Ft.

Dry Hole _____

Abandoned _____

Date

AUG 31 1949

19

S. J. LEWIS

Scout