


Section 1 Township 10 Range 23 W

Well No. #1 Stites

Company Heathman & Seeligson

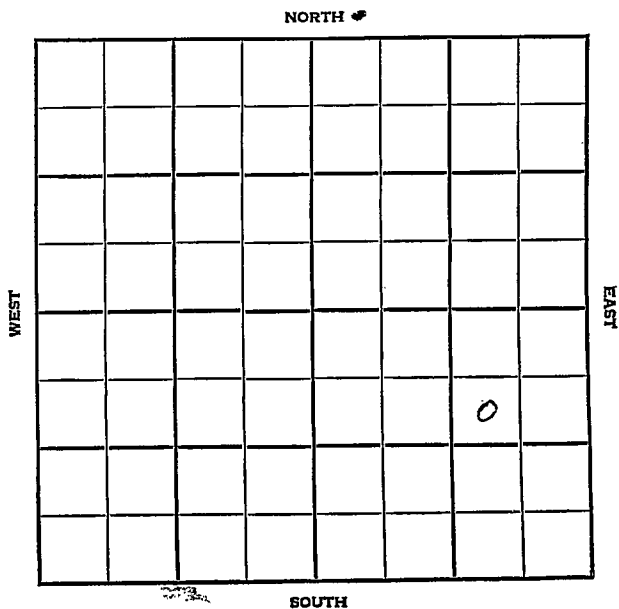

Graham

KANSAS

SEC.	TWP.	R.
1	10	23W

WELL NO.

#4 Stites

FARM

COMPANY

Heathman & Seeligson

CONTRACTOR


SE Law Pool

_____ Ft. from N. Line

_____ Ft. from S. Line

_____ Ft. from E. Line

_____ Ft. from W. Line

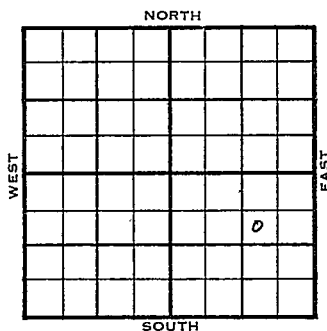

SW NE SE

	ELEVATION	REPORT
1955	2375	

9/7 Location

10/12

Comm 9/11/55
 8 5/8" @ 169 w/125'
 Anh 1934
 H 3614
 L 3650
 BKG 3872
 TD 4067
 DST 3777-3800 open 2 hrs Rec 95'
 socsw BHP 1195# 20" DST 3803-19
 open 1 hr Rec 10' M BHP 0-20
 5 1/2" @ 3918 2/100 CO 36/3819-
 29 @ 500 Acid Swb 9.86 BOPH 5 hrs
 POP 378 bopd no wtr

COMPLETED

County Graham Elev. _____
 Sec. 1 Twp. 10 Rge. 23W
 Company Heatman & Seeligson
 Farm Name Stites No. 1

Co. _____
 Lse. _____
 No. _____
 Sec. _____
 T. _____
 R. _____

TOPS	DEPTH	LOG	DATUM
Anh.			
Tp.			
H.			
Tr.			
Dg.			
Bl.			
L.			
K.C.			
B.K.C.			
Ce.			
C.			
M.			
M.			
K.			
Mz.			
Ma.			
V.			
S.			
S.			
A			
R.			
PE.			
G.			
TD.			

Loc. in Sec. _____
SW NE SE
 Geol. _____
 Contr. _____
 Pool _____
SE Low Pool

FIRST REPORT
 SEP 7 '55

Date Comm. _____
 Location _____

[Handwritten signature]

County Graham Elev. 2375
 Sec. 1 Twp. 10 Rge. 23W
 Company Heathman & Seeligson
 Farm Name Stites No. 4

TOPS	DEPTH	LOG	DATUM	Loc. in Sec.
Anh.	<u>1934</u>			SW NE SE
Tr.				
H.	<u>3614</u>		<u>12.38</u>	
Dg.				
Bl.				
L.	<u>3650</u>		<u>12.75</u>	Geol.
K.C.				Contr.
B.K.C.	<u>3872</u>		<u>14.97</u>	
Ce.				
C.				
M.				Pool
M.				SE Law Pool
K.				
Mz.				
Ma.				
V.				
S.				
S.				
A.				
R.				
PE.				
G.				
T.D.	<u>4067</u>			

COMPLETE

Date Comm. 9/11/55 OCT 12 1955

8 5/8 169 w/125 DST 3777-3800 open 2 hrs
Rec. 95' socsw BHP 1195# 20" DST 3803-19
open 1 hr Rec. 10' M BHP 0-20 5 1/2 3918
2/100 CO 36/3819-29 500 Acid Swb 9.86
BOPH 5 hrs POP 378 bopd no wtr

Co. No. Use. No. Sec. T. R.