
Graham

KANSAS

SECTION 10 TOWNSHIP 10S RANGE 25W

WELL NO. #5 Mary Dinkel "B"

COMPANY Empire & N. C. R. A.

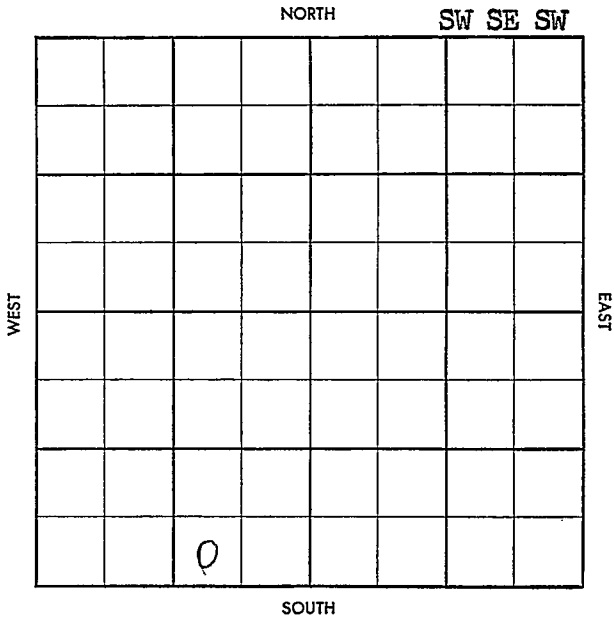

FORM 504-3 SUNRAY

Twp. X Feet X

Co. X Feet

S-513-B

County Graham Elev. 2513 DF, 2516 RB

Sec. 10 Twp. 10 Rge. 25W

Company Empire & N.C.R.A.

Farm Name Mary Dinkel "B" No. 5


TOPS	DEPTH	LOG	DATUM
Anh.	2137		
Tp.			
H.	3743		
Tr.	3766		
Dg.			
B. L.			
L.			
K.C.			
B.K.C.			
Ce.			
C.			
M.			
M.			
K.			
Mz.			
Mq.			
V.			
S.			
S.			
A.			
R.			
Pf.			
G.			
T.D.			

Loc. in Sec. SW SE SW

Geol.

Contr. Empire Drlg.

Pool Elrick NE

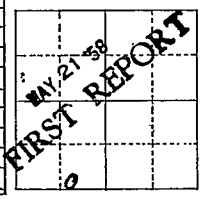

Date Comm. 5/14/58

8" @ 125 w/100, DST 3766-75/60, 90' Mud SSO, 180' O &GCM, FPO# BHP 1140/30, Drlg. 3775

Co. Lse. No. Sec. T. R.

Twp. X Pool X

Co. X Facet X

S-513-B

County Graham Elev. 2513 DF, 2516 RB

Sec. 10 Twp. 10 Rge. 25W

Company Empire & N.G.P.A.

Farm Name Mary Dinkel "B" No. 5

TOPS	DEPTH	LOG	DATUM
Anh.	2137		
Tp.			
H.	3743	3740	
Tr.	3766	3763	
Dg.			
B.L.			
L.		3773	
K.C.			
B.K.C.			
Ce.			
C.			
M.			
M.			
K.			
Mz.			
Mq.			
V.			
S.			
S.			
A.			
R.			
Pf.			
G.			
T.D.	4010	4007	

Loc. in Sec. SW SE SW

Geol.

Contr. Empire Drlg.

Pool Elrick NE

COMPLETE

JUN 11 '58

0

Date Comm. 5/14/58

8" @ 125 w/100, DST 3766-75/60, 90' Mud SSO, 180' O &GCM, FPO# BHP 1140/30, Drlg. 3775

MAY 28 '58 DST 3803-20 1hr 9/16" Flo out 58" FP 330-1160 BHP 1380/30" 5" 4009/100 CO 24/ 3974-80 (½) $1 Boph NW 2hrs (2) $30 Boph NW 8hrs POP

JUN 3 '58 JUN 11 '58 Phy P 2480 NW Lsg 3974-80