

# KANSAS

Rooks


FORM 51 5M 1-42 PETROL

Section 10 Township 10 Range 16-W

Well No. 1 Baum

Company Palmer Oil

NORTH Wildcat

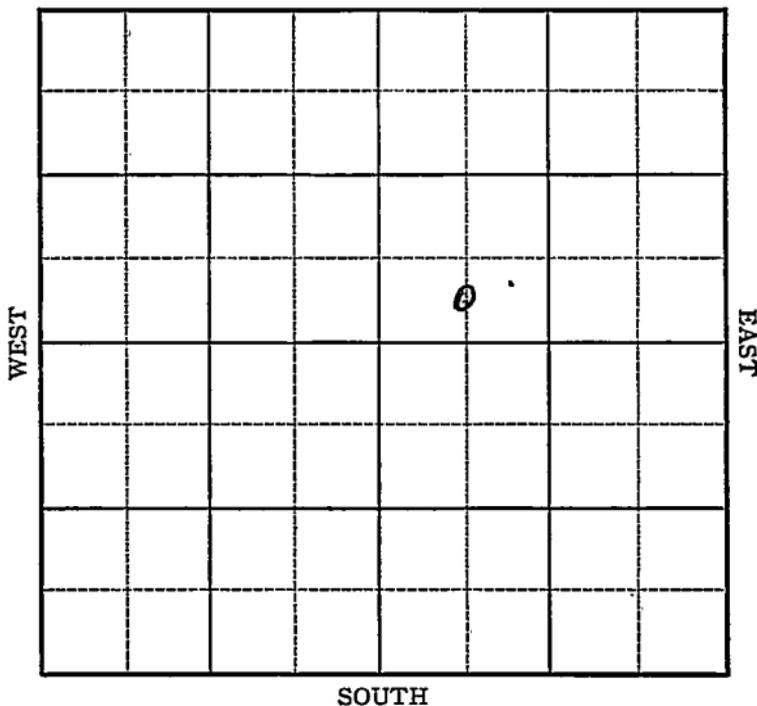



1942

4/8

Lans. 3040'

Arb. 3488'

5" - 3220'

T.D. 3520'

96 shots 3057-3127'

7000 acid.

Potential 210 bbls., pump.

38. Gravity

**COMPLETED**

Map No. 64 Sec. 10 Twp. 10 R. 16WWell No. 1 BaumPalmer Oil Company**FIRST REPORT** Contractor

C SL SW NE

\_\_\_\_\_ Ft. from N. Line

330 Ft. from S. Line

\_\_\_\_\_ Ft. from E. Line

660 Ft. from W. Line

## SECTION PLAT


WILDCAT

Location XXX

Rig up \_\_\_\_\_

Drilling and Remarks:

.

## RECORD

Cased \_\_\_\_\_ in., \_\_\_\_\_ ft.

Sand \_\_\_\_\_

Gas \_\_\_\_\_

Oil \_\_\_\_\_

Total Depth \_\_\_\_\_

## PRODUCTION

1st 24 hrs. Nat. \_\_\_\_\_

1st 24 hrs. after shot \_\_\_\_\_

Gas \_\_\_\_\_ Cu. Ft.

Dry Hole \_\_\_\_\_

Abandoned ✓

Date

FEB 1 8 1942 19S. J. LEWIS Scout

Map No. 64 Sec. 10 Twp. 10 R. 16WWell No. 1 BaumPalmer Oil Company**COMPLETED**

Contractor

C SL SW NE

SECTION PLAT

		o	

         Ft. from N. Line330 Ft. from S. Line         Ft. from E. Line660 Ft. from W. Line

BAUM POOL

Location                                 Rig up                                 

Drilling and Remarks:

*Lans 3040*  
*CR 7 3488.*  
*5" @ 3220*  
*966 to the 3059-3127*  
*7000 Acid*  
*Pump .210 P.V.*  
*38° G.*

## RECORD

Cased          in.,          ft.Sand                                 Gas                                 Oil                                 Total Depth 3520

## PRODUCTION

1st 24 hrs. Nat.                         1st 24 hrs. after shot                         Gas                                  Cu. Ft.Dry Hole                                 Abandoned                                 

Date

APR 8 1942 19S. J. LEWIS Scout