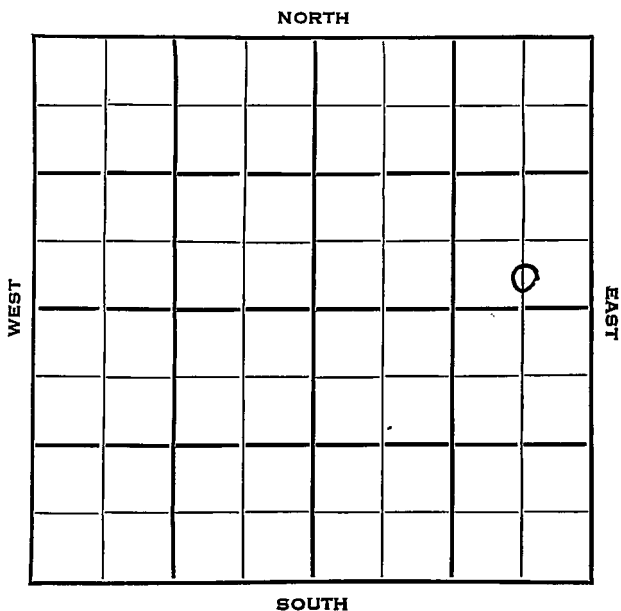
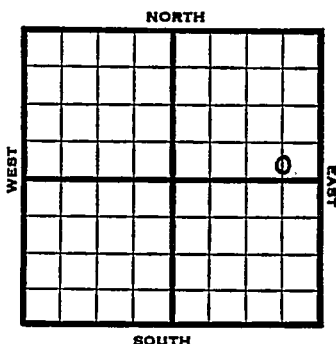


Section 10 Township 10 **KANSAS** Range 16 WWell No. # 1 WellingCompany Transit & Krueger

Sec. 10 Twp. 10 R. 16WWell No. #1 Welling FarmTransit & Krueger CompanyTransit ContractorBaum Pool
Ft. from N. Line330 Ft. from S. Line660 Ft. from E. Line Ft. from W. LineC S L SE NE
CSO - DHM


1953 Elev. 1911' REPORT

5/27 Spud 5-21-53
8" @ 124'
Anhy 1080'
Drlg 2207'

6/3 Top 2779, Heeb 3010, Tor 3031, Lans 3055,
DS¹ 3015-80 1 hr, 6' M scom oil
DST 3088-3120 1 hr, 25' ocm 280#
Drlg 3227'

6/10 Spud 5-21-53
D & A
TD 3514'
8" @ 124'
Anhy 1080', Top 2779, Heeb 3010, Tor 3031, Lans 3055,
DST 3015-80 opn 1 hr, rec 6' mud 0#
DST 3088-3120 opn 1 hr, rec 25' ocm 280#
DST 3257-82 opn $\frac{1}{2}$ hr, rec 10' socm 990#
B KC 3301, Cong 3381, Arb 3475,
TD 3514'
D & A

ABANDONED

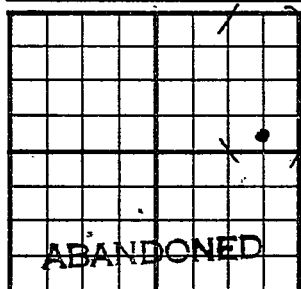County _____ Rocks _____ State KansasSec. 10 (Blk. Twp.) 10 (Sur. Rge.) 16W Map No. _____Operator Transit & KruegerWell No. 1 Farm. Welling.Elev. 1911 Location C S L SE NE330 Ft. From S Line NE660 Ft. From E Line Quarter

1st. Report _____

Completion JUN 10 1953Remarks Baum PoolTransit - Contr.Spudding Date 5-21-53Drig. Data D & A TD 35148" @ 124 Anhy 1080 Top. 2779Heeb. 3010 Tor. 3031 Lans. 3055DST 3015-80 open 1 hr. Rec. 6' mud0# DST 3088-3120 open 1 hr. Rec.25' ocm 280# DST 3257-82 open $\frac{1}{2}$ hr.Rec. 10' soom 990# R KC 3301Cong. 3381 Arb. 3475 TD 3514D & A

J. G. McGEHEE