


Rooks

KANSAS

SECTION 10 TOWNSHIP 10S RANGE 18W

WELL NO. #1 Jones

COMPANY Davis Bros. & Leben

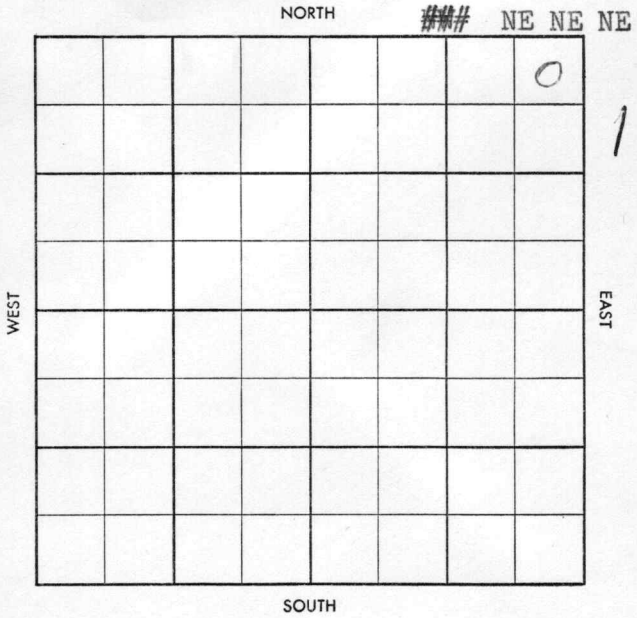

~~WILDCAT~~
WILDCAT

S-513-B

County Rooks Elev. _____
Sec. 10 Twp. 10 Rge. 18W
Company Davis Bros. & Leben
Farm Name Jones No. 1

TOPS	DEPTH	LOG	DATUM
Anh.			
Tp.			
H.			
Tr.			
Dg.			
B.L.			
L.			
K.C.			
B.K.C.			
Ce.			
C.			
M.			
M.			
K.			
Mz.			
Mq.			
V.			
S.			
S.			
A.			
R.			
Pf.			
G.			
T.D.			

Loc. in Sec. _____
NE NE NE
Geol. _____
Contr. _____
Leben Drlg
Pool _____
Wildcat

FIRST REPORT
APR 30 1939

Date Comm. MIR CSO & Sterling-support CSO-DIM

Co.
Lse
No.
Sec.
T.
R.

Top ~~Pool~~

Co ~~Foot~~

S-513-B


County Rooks Elev. 2179 or 2151
 Sec. 10 Twp. 10 Rge. 18W
 Company Davis Bros. & Leben
 Farm Name Jones No. 1

TOPS-	DEPTH	LOG	DATUM
Anh.	1492		
Tp.	3132		
H.	3350		
Tr.	3370		
Dg.			
B.L.			
L.	3394		
K.C.	3632		
M.R.C.	3649		
Ce.	3626		
C.	3654		
M.			
M.			
K.			
Mz.			
Mq.			
V.			
S.	3683		
S.	3739		
A.	3763		
R.			
Pf.			
G.			
I.D.	3795		

Loc. in Sec. NE NE NE

Geol. #3
Contr. Leben Drlg

Pool Wildcat

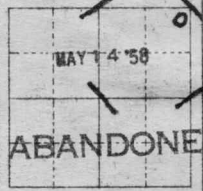

Date Comm. 4-29-58 CSO & Sterling-support CSO-DIM

M I R MAY 7 '58 8" 192/100 \$2630,
 MAY 14 '58 DST 3541-3603 2 hrs 15'
 Socm 30' M sp. soil FPO
 BHP 160/2" ~~4325~~ run log

D-6A