

Sec. 10 Twp. 10 R. 19-W


Well No. #1 Mitchell Farm
Tom Allan et al Company
(Zurich)

330 Ft. from N. Line

_____ Ft. from S. Line

660 Ft. from E. Line

_____ Ft. from W. Line

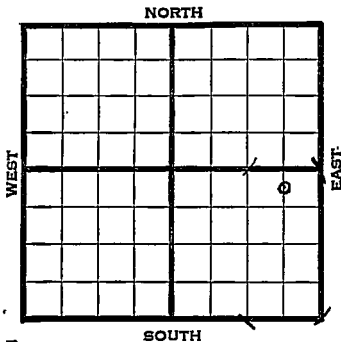

Elev. 2145

1941

REPORT

8/13 Move in Roty Rig.

8/21 8" - 121' Drlg. 2160'

8/28 Topeka 3104' Drlg. 3352'

9/3 Lans. 3350'

Cong. 3608'

Viola 3610'

Arb. 3690'

T.D. 3720'

No shows.

ABANDONED

Map No. 65 Sec. 10 Twp. 10 R. 19WWell No. 1 MitchellTom Allan etal

Company

~~STAY REPORT~~

Contractor

C N L N E S E

SECTION PLAT


330 Ft. from N. Line

_____ Ft. from S. Line

660 Ft. from E. Line

_____ Ft. from W. Line

ZURICH POOL

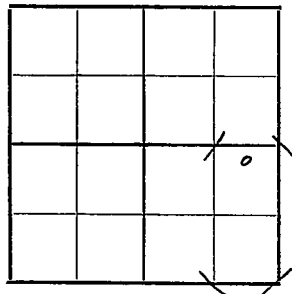

Location _____

Rig up _____

Drilling and Remarks:

Move in Rotary
Rig.

RECORD

Cased _____ in., _____ ft.

Sand _____

Gas _____

Oil _____

Total Depth _____

PRODUCTION

1st 24 hrs. Nat. _____

1st 24 hrs. after shot _____

Gas _____ Cu. Ft.

Dry Hole _____

Abandoned _____

Date

AUG 13 1941

S. J. LEWIS

Scout

Map No. 65 Sec. 10 Twp. 10 R. 19WWell No. 1 MitchellTom Allan etal

Company

~~ABANDONED~~

Contractor

C N L NE SE

330 Ft. from N. Line

Ft. from S. Line

660 Ft. from E. Line

Ft. from W. Line

ZURICH POOL

SECTION PLAT

			o

Location _____

Rig up _____

Drilling and Remarks:

Lease 3350
Comp 3608
Vid 3610
Act. 3690
No shows

RECORD

Cased _____ in., _____ ft.

Sand _____

Gas _____

Oil _____

Total Depth 3720

PRODUCTION

1st 24 hrs. Nat. _____

1st 24 hrs. after shot _____

Gas 1 _____ Cu. Ft.

Dry Hole _____

Abandoned _____

Date

SEP 3 1941 19S. J. LEWIS Scout