

Sec. 10 Twp. 10 R. 20W

Well No. #6 Downey Farm

B & R Drlg. Company


Contractor

990 Ft. from N. Line

Ft. from S. Line

Ft. from E. Line

990 Ft. from W. Line

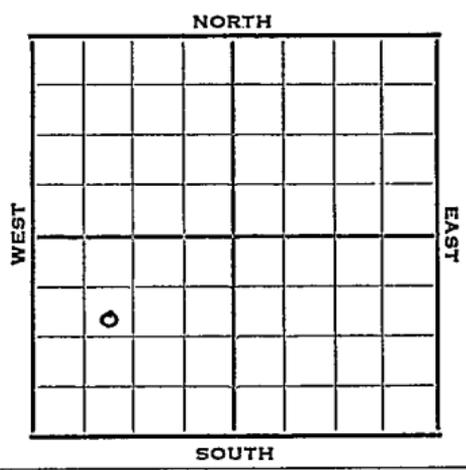

SE NW SW

1952

Elev. 2221' REPORT

6/25 Cellar & Pits

7/2 8" @ 189

Drlg. 3000'

7/9 Spud 6-25-52

D & A TD 3841' 8" @ 189

Top. 3252' Heeb 3460' Lans. 3492'

B KC 3714' Cong. 3748' Arb. 3825'

TD 3841'
D & A

ABANDONED

County _____ Rooks State **Kansas**

Sec. 10 (Blk. Twp.) 10 (Sur. Rge.) 20W Map No.

Operator **B & R Drlg.**

Well No. 6 Farm Downey

Elev. 2221 Location SE NW SW

| | | | | | |
|--|--|--|--|--|--|
| | | | | | |
| | | | | | |
990 Ft. From N Line SW

990 Ft. From W Line Quarter

Ist. Report

Completion JUL 9 1952

Remarks

Spudding Date 6-25-52

Drlg. Data D & A TD 3841

8" @ 189 Top. 3252 Heeb. 3460

Lans. 3492 B KC 3714 Cong. 3748

Arb. 3825 TD 3841

D & A