

Well No. 1 Dunlap

Company B & R Drlg.

Marcotte

NORTH

WEST

EAST

SOUTH

0

Rooks KANSAS

Sec. 10 Twp. 10 R. 20W

Well No. #1 Dunlap Farm

B & R Drlg. Company

Marcotte (B & R Drlg. Cont.)

Pool


 Ft. from N. Line

330' Ft. from S. Line

330' Ft. from E. Line

 Ft. from W. Line

SE SW

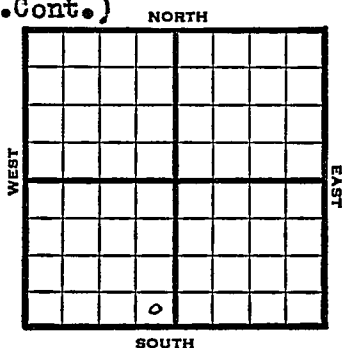

1949

Elev 2224' REPORT

6/22	8" @ 183'
	WOC
6/28	"
7/6	"
7/12	Lansing 3492'
	Arb. 3781-84'
	TD 3784'
	5"@ 3782'
7/20	"
7/27	"
8/3	"
8/10	"
8/17	TD 3787'
	Arb. 3782'
	5"@ 3782'
	500 acid
	Pump 80 oil Pot
	27° Gr.
	Comp

COMPLETED

Kansas

Marcotte Pool

Map No. _____ Sec. 10 Twp. 10 R. 20W

Well No. 1 Dunlap


B & R Drlg.

Company

B & R

Contractor

SE SW

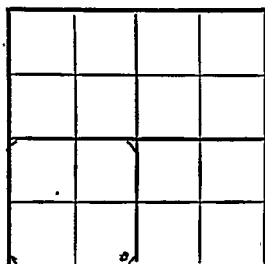FIRST REPORT
SECTION PLAT

_____ Ft. from N. Line

330 _____ Ft. from S. Line

330 _____ Ft. from E. Line

_____ Ft. from W. Line

Rooks County

RECORD

Location _____

Cased _____ in., _____ ft.

Rig up _____

Sand _____

Drilling and Remarks:

Gas _____

Oil _____

8" @ 183 WOC

Total Depth _____

PRODUCTION

1st 24 hrs. Nat. _____

1st 24 hrs. after shot _____

Gas _____ Cu. Ft.

Dry Hole _____

Abandoned _____

Date

JUN 22 1949

19

S. J. LEWIS

Scout

Map No. K65 Sec. 10 Twp. 10 R. 20W

Well No. 1 Dunlap

B & R Drlg. Company

COMPLETE

SE SW

Contractor


E. 2224
SECTION PLAT

 Ft. from N. Line

330 Ft. from S. Line

330 Ft. from E. Line

 Ft. from W. Line

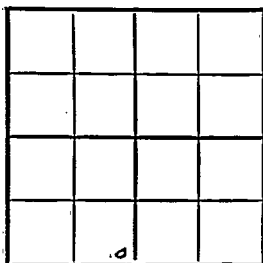

Rooks County

RECORD

Location

Cased in., ft.

Rig up

Sand

Drilling and Remarks:

Gas

Oil

Total Depth 8787

PRODUCTION

1st 24 hrs. Nat.

1st 24 hrs. after shot

Gas Cu. Ft.

Dry Hole

Abandoned

Ar 83782
S-1 @ 3782
50000000
Pump, Soil Bt
27-82

Date

AUG 17 1949 19

S. J. LEWIS Scout