


KANSAS

Rooks County

Section 10 Township 10 Range 20-WWell No. #1 HinkhouseCompany Champlin Ref
Marcotte Pool

NORTH

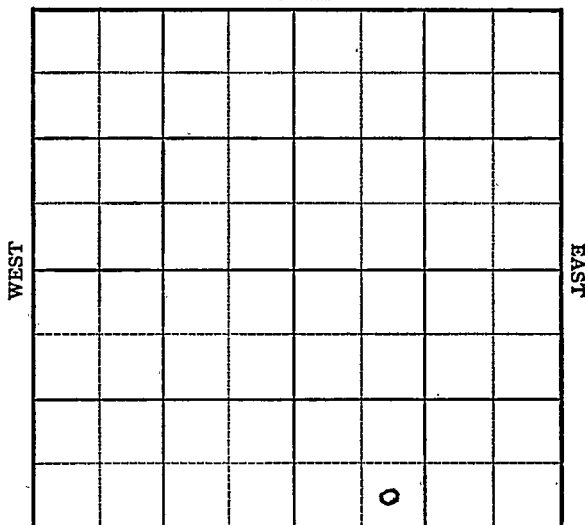

Sec. 10 Twp. 10 R. 20W

Well No. 1 Hinkhouse Farm

Champlin Ref. Company


Marcotte Pool Contr. Champlin

 Ft. from N. Line

330 Ft. from S. Line

 Ft. from E. Line

990 Ft. from W. Line

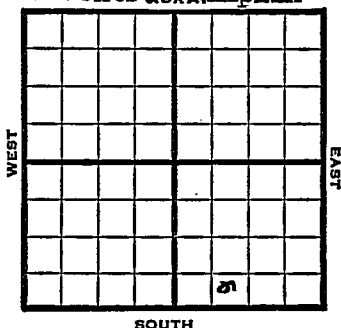

SE SW SE

1949	Elev 2226' REPORT
8/24	Location
8/31	Surface Hole
9/7	8" @ 181'
	Drlg. 3404'
9/14	TD 3828' in Cong.
	Top 3282'
	Lans 3507'
	Cong 3787'
	Aband.
	ABANDONED

Map No. _____ Sec. 10 Twp. 10 R. 20W


Well No. 1 Hinkhouse

Champlin Ref. _____ Company

Champlin _____ Contractor

**FIRST REPORT
SECTION PLAT**

SE SW SE

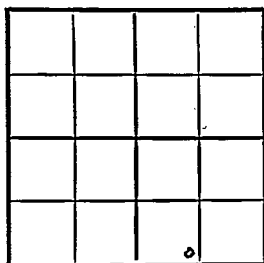

_____ Ft. from N. Line

330 _____ Ft. from S. Line

_____ Ft. from E. Line

990 _____ Ft. from W. Line

Rooks County

RECORD

Location _____ X

Rig up _____

Drilling and Remarks: _____

Cased _____ in. _____ ft.

Sand _____

Gas _____

Oil _____

Total Depth _____

PRODUCTION

1st 24 hrs. Nat. _____

1st 24 hrs. after shot _____

Gas _____ Cu. Ft.

Dry Hole _____

Abandoned _____

Date

AUG 24 1949 19

S. J. LEWIS Scout

Map No. K65 Sec. 10 Twp. 10 R. 20W

Well No. 1 Hinkhouse

Champlin Ref.


Company

ABANDONED

Contractor

SE SW SE

E12226
SECTION PLAT

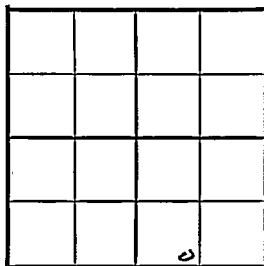

_____ Ft. from N. Line

330 Ft. from S. Line

_____ Ft. from E. Line

990 Ft. from W. Line

Rooks County

Location _____

Rig up _____

Drilling and Remarks:

*Log 3282.
Lans 3587
Core 3787*

RECORD

Cased _____ in., _____ ft.

Sand _____

Gas _____

Oil _____

Total Depth 3728 in. Core

PRODUCTION

1st 24 hrs. Nat. _____

1st 24 hrs. after shot _____

Gas _____ Cu. Ft.

Dry Hole _____

Abandoned _____

Date

SEP 14 1949

19

S. J. LEWIS

Scout