

Section 10 Township 10 Range 20-WWell No. #3 RogersCompany Barnett & Shields

NORTH

		o					

WEST

EAST

SOUTH

3

KANSAS

Rooks

Sec. 10 Twp. 10 R. 20W

Well No. #3 Rogers Farm

Barnett & Shields Company

Barnett & Shields Contractor


330' Ft. from N. Line

Ft. from S. Line

990' Ft. from E. Line

Ft. from W. Line

NW NE NW

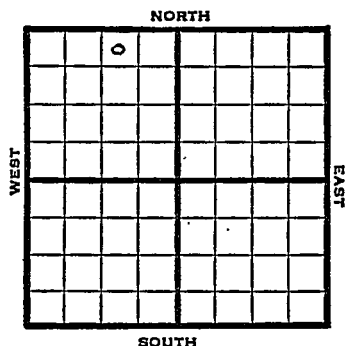

1950 Elev 2227

REPORT

5/31 Location

8/9 8" @ 128

Anhy 1702

Top 3253

Heeb 3456

Lans 3495

B KC 3716

Arb 3786-88

TD 3800

FU 800' oil 500 A

Comp 248 bopd

Completed

COMPLETED

Map No. _____ Sec. 10 Twp. 10 R. 20WWell No. 3 RogersBarnett & Shields CompanyBarnett & Shields Contractor

NW NE NW

SECTION PLAT

330 Ft. from N. Line

_____ Ft. from S. Line

990 Ft. from E. Line

_____ Ft. from W. Line

FIRST REPORT			

Rocks

Location X

Rig up _____

Drilling and Remarks:

RECORD

Cased _____ in., _____ ft.

Sand _____

Gas _____

Oil _____

Total Depth _____

PRODUCTION

1st 24 hrs. Nat. _____

1st 24 hrs. after shot _____

Gas _____ Cu. Ft.

Dry Hole _____

Abandoned _____

Date

MAY 31 1950₁₉J. E. TYRA Scout

County Rooks State Kansas
 Sec. 10 (Blk.) 10 (Sur.) 20W Map No.
 Operator Barnett & Shields
 Well No. 3 Farm Rogers
 Elev. 2227 Location NW NE NW

		0					

330 Ft. From N Line NW
990 Ft. From E Line Quarter

1st. Report

Completion AUG 9 1950

Remarks

Spudding Date

Drlg. Data

8" @ 128 Anhy 1702 Top. 3253 Heeb.

3456 Lans. 3495 B KC 3716 Arb. 3786-

88 TD 3800 FU 800' oil 500 A

Comp. 248 hpd

J. E. TYRA