

FORM 51


Rooks

KANSAS

Section 10 Township 10 Range 20W

Well No. 3 Sparks "A"

Company Barnett Oil

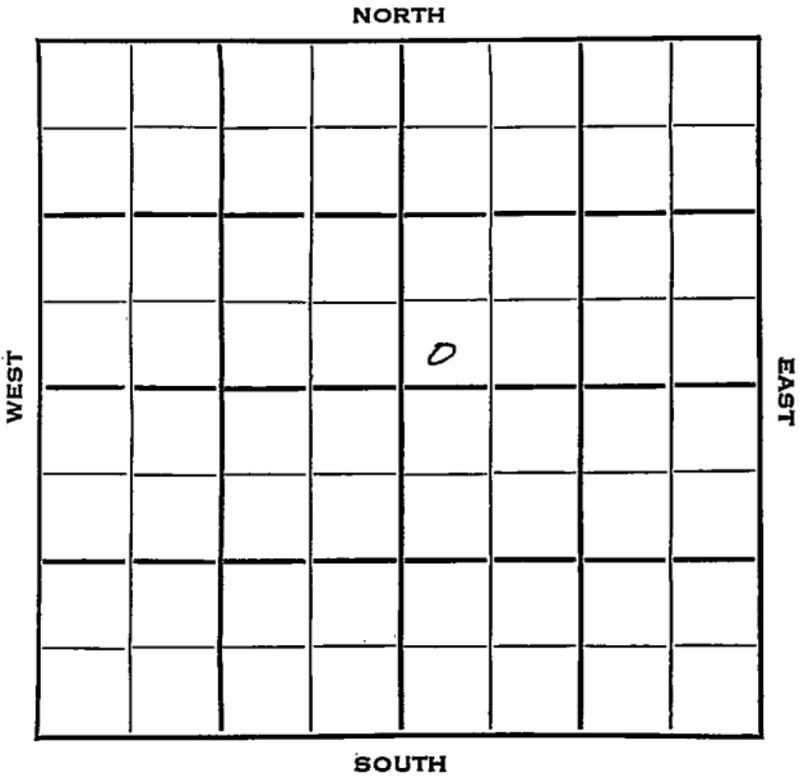

Sec. 10 Twp. 10 R. 20W

Well No. 3 Sparks "A" Farm

Barnett Oil Company

Barnett Drlg. Contr. Contractor


Ft. from N. Line

330' Ft. from S. Line

Ft. from E. Line

330' Ft. from W. Line

SW SW NE

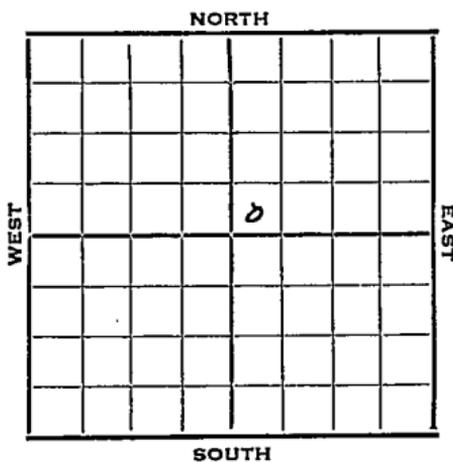

1953 Elev. 2251 REPORT

1/7 Spudding Date 1/1/53  
 8" @ 140 Drlg. 2650

1/15 Drlg. 3825'

1/23 Spud 1-1-53

D&A

TD 3846

8" @ 140,

Heeb 3484, Lans 3523, Arb.

3825

DST 3830-38, opn 1/2 hrs., rec.

60' mud, 380#

TD 3846

D&A

**ABANDONED**

County \_\_\_\_\_ Rocks \_\_\_\_\_ State **Kansas**

Sec. **10** (Blk. Twp.) **10** (Sur. Rge.) **20W** Map No. \_\_\_\_\_

Operator **Barnett Oil**

Well No. **3** Farm **Sparks "A"**

Elev. **2251** Location **SW SW NE**

			0		

**330**Ft. From **S** Line **NE**

**330**Ft. From **W** Line **Quarter**

Ist. Report **JAN 7 1953**

Completion \_\_\_\_\_

Remarks \_\_\_\_\_

**Barnett Drlg. - Contr.**

Spudding Date **1-1-53**

Drlg. Data

**8" @ 140 drlg. 2650**

