
KANSAS Rooks

FORM 51 25M 3-49 PETROL

Section 10 Township 10 Range 20-W

Well No. #2 Hinkhouse

Company Champlin Ref
Marcott Pool

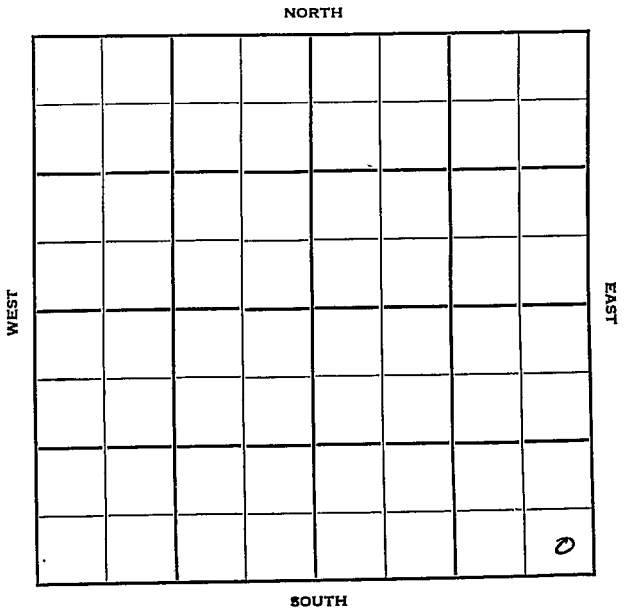

16

FORM 252-B
10M 9-49 PETROL

Rooks KANSAS

Sec. 10 Twp. 10 R. 20W

Well No. #2 Hinkhouse Farm

Champlin Ref. Company

B & R Drlg. Contractor

Marcott Pool


_____ Ft. from N. Line

330' Ft. from S. Line

330' Ft. from E. Line

_____ Ft. from W. Line

SE SE SE

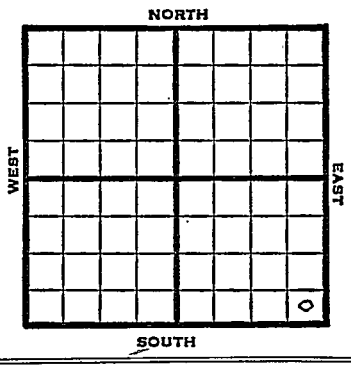

1950	Elev 2218' REPORT
3/8	Spud 3-6-50 8" @ 250' WOC
5/3	TD 3773' 8" set 250' Topeka 3244' KC 3485' Cong 3733 Simp 3758' Arb. 3770' 5"@ 3771' 147 BOPD Comp
	COMPLETED

Form 26 200 Bks. 11-49 Petrol

Kansas

Marcott Pool

Map No. _____ Sec. 10 Twp. 10 R. 20W

Well No. 2 Hinkhouse

Champlin Ref. Company

B & R Drlg. Contractor

SE SE SE

_____ Ft. from N. Line

330 Ft. from S. Line

330 Ft. from E. Line

_____ Ft. from W. Line

Rooks County

SECTION PLAT



Location _____

Rig up _____

Drilling and Remarks:

Spud 3-6-50

8" @ 250

WOC

RECORD

Cased _____ in., _____ ft.

Sand _____

Gas _____

Oil _____

Total Depth _____

PRODUCTION

1st 24 hrs. Nat. _____

1st 24 hrs. after shot _____

Gas _____ Cu. Ft.

Dry Hole _____

Abandoned _____

Date

MAR 8 1950 19 J. E. TYRA Scout

Form 26 200 Bks. 11-49 Petrol

Kansas

Marcott Pool

Map No. _____ Sec. 10 Twp. 10 R. 20W

Well No. 2 Hinkhouse


Champlin Ref. Company

Contractor

SE SE SE

El. 2218

SECTION PLAT

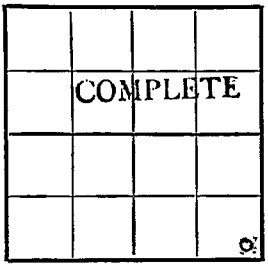

_____ Ft. from N. Line

330 Ft. from S. Line

330 Ft. from E. Line

_____ Ft. from W. Line

Rooks County

Location _____

Rig up _____

Drilling and Remarks:

8" @ 250

Topeka 3244

K.C. 3485

Cong 3733

Simp 3758

Arb 3770

5" @ 3771

RECORD

Cased _____ in., _____ ft.

Sand _____

Gas _____

Oil _____

Total Depth 3773

PRODUCTION

1st 24 hrs. Nat. _____

1st 24 hrs. after shot _____

Gas _____ Cu. Ft.

Dry Hole _____

Abandoned _____

147 BOPD

Date

MAY 3 1950 19

J. E. TYRA Scout