

Section 10 Township 10 Range 20WWell No. #1 RogerCompany Barnett Oil

Palco Pool

NORTH

WEST

EAST

0							

SOUTH

4

Rooks

KANSAS

Sec. 10 Twp. 10 R. 20W

Well No. #1 Roger Farm

Barnett Oil

Company


Palco Pool (Barnett Oil, Contr.)

330' Ft. from N. Line

 Ft. from S. Line

 Ft. from E. Line

660' Ft. from W. Line

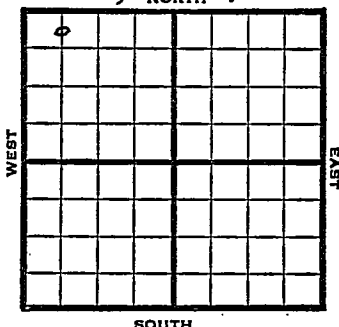

C N L NW NW

1949 Elev 2208' REPORT

12/7 8" @ 123'
Anhy 1688'
Drlg. 1975'

12/14 Drlg. 3676'

12/21 Arb. 3764' - 66'
TD 3766'
5" @ 3765'

12/28 TD 3772'
700 acid

1950
1/11 TD 3772'
8" @ 123'
5" @ 3765'
Complete as a 3000 BOPD
Comp
Anhy 1688'
Heb 3430'
Lan 3469'
BKC 3697'
Simp 3762'
Comp

COMPLETED

Map No. _____ Sec. 10 Twp. 10 R. 20W

Well No. 1 Roger

Barnett Oil Company

Barnett Drlg. Contractor

C N L NW NW


**FIRST REPORT
SECTION PLAT**

330 Ft. from N. Line

_____ Ft. from S. Line

_____ Ft. from E. Line

660 Ft. from W. Line

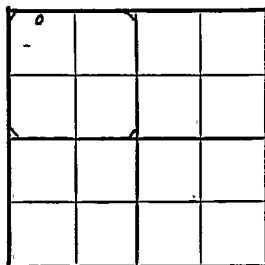

Rooks County

Location _____

Rig up _____

Drilling and Remarks:

8" @ 123

Anhy 1688

drlg. 1975

RECORD

Cased _____ in., _____ ft.

Sand _____

Gas _____

Oil _____

Total Depth _____

PRODUCTION

1st 24 hrs. Nat. _____

1st 24 hrs. after shot _____

Gas _____ Cu. Ft.

Dry Hole _____

Abandoned _____

Date

DEC 7 1949

S. J. LEWIS Scout

Kansas

Palco Pool

Map No. _____ Sec. 10 Twp. 10 R. 20WWell No. 1 Roger

Barnett Oil

Company


Contractor

C N L NW NW

Elev. 2208
SECTION PLAT330 Ft. from N. Line

_____ Ft. from S. Line

_____ Ft. from E. Line

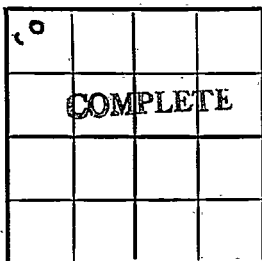660 Ft. from W. Line

COMPLETE

Rooks County

RECORD

Location _____

Rig up _____

Drilling and Remarks:

8" @ 123
 5" @ 3765
 Complete as
 a 3000 B.O.P.D.

Cased _____ in., _____ ft.

Sand _____

Gas _____

Oil _____

Total Depth 3772

PRODUCTION

1st 24 hrs. Nat. _____

1st 24 hrs. after shot _____

Gas _____ Cu. Ft.

Dry Hole _____

Abandoned _____

Date

JAN 11 1950 19

J. E. TYRA Scout

Anky - 1688
Hib 3430
Tan 3469
BKC 3697
Simp 3762

JAN 16 1950

Scout Cards
Land Small Map
Land Wall Map
Tracings
France Map
Pierce Map
Misc.

Edith
67