
FORM 51 25M 3-49 PETROL

KANSAS Rooks

Section 10 Township 10 Range 20-W

Well No. #2 Rogers

Company Barnett Oil
Palco SE

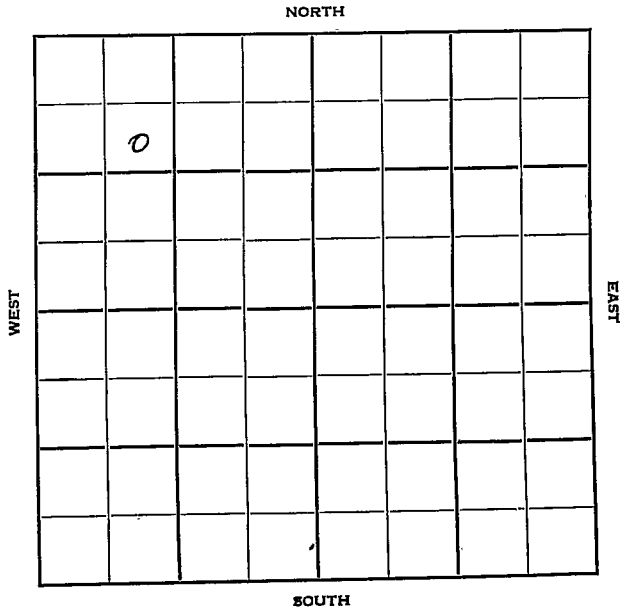

FORM 252-B
10M 9-49 PETROL

KANSAS

Rooks

Sec. 10 Twp. 10 R. 20W

Well No. #2- Rogers Farm

Barnett Oil Company

Contractor

Palco SE


990' Ft. from N. Line

Ft. from S. Line

Ft. from E. Line

990' Ft. from W. Line

SE NW NW

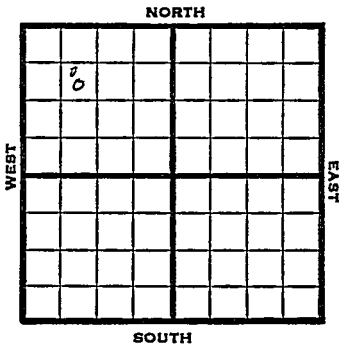

1950	Elev 2200' REPORT
3/1	MIM
4/5	TD 3777' 8"@ 125' 5"@ 3771' Lans 3474' Cong 3721' Simp 3749' Arb. 3771' 736 BOPD Comp COMPLETED

Form 26 200 Bks. 11-49 Petrol

Kansas

Palco SE

Map No. _____ Sec. 10 Twp. 10 R. 20W

Well No. 2 Rogers

Barnett Oil Company

_____ Contractor

SE. NW NW

990 Ft. from N. Line


_____ Ft. from S. Line

_____ Ft. from E. Line

990 Ft. from W. Line

Rooks County

SECTION PLAT

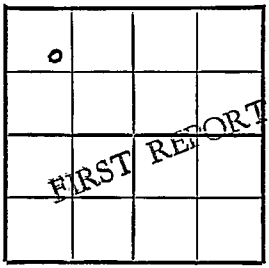

Location _____

Rig up _____

Drilling and Remarks:

M I M

RECORD

Cased _____ in., _____ ft.

Sand _____

Gas _____

Oil _____

Total Depth _____

PRODUCTION

1st 24 hrs. Nat. _____

1st 24 hrs. after shot _____

Gas _____ Cu. Ft.

Dry Hole _____

Abandoned _____

Date

MAR 1 1950

19 _____

J. E. TYRA

_____ Scout

Form 26 200 Bks. 11-49 Petrol

Palco SE

Kansas

Map No. _____ Sec. 10 Twp. 10 R. 20W

Well No. 2 Rogers


Barnett Oil Company

Contractor

SE NW NW

El. 2200

SECTION PLAT

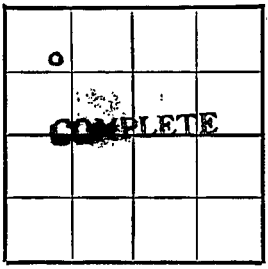

990 Ft. from N. Line

Ft. from S. Line

Ft. from E. Line

990 Ft. from W. Line

Rooks County

Location

Rig up

Drilling and Remarks:

8"@ 125
5"@ 3771
Lans 3474
Conq 3721
Lans 3749
Arb 3771
736 BOPD

RECORD

Cased in., ft.

Sand

Gas

Oil

Total Depth 3777

PRODUCTION

1st 24 hrs. Nat.

1st 24 hrs. after shot

Gas Cu. Ft.

Dry Hole

Abandoned

Date

APR 5 1950 19

J. E. TYRA Scout