

Sec. 10 Twp. 10 R. 21W ✓

Well No. #3 Bartos Farm

Anderson-Prichard Company

Contractor


330' Ft. from N. Line

Ft. from S. Line

Ft. from E. Line

330' Ft. from W. Line

NW NW NE

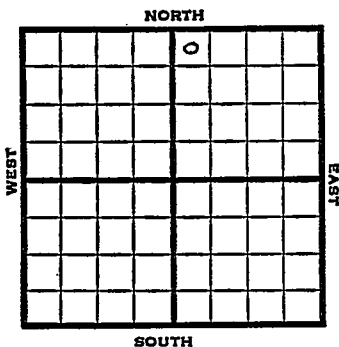

1951

Elev. 2271' REPORT

1/3

Drlg.

2/14

Spud 12-29-50
 Oil W 11 TD 3842'
 8" @ 259' Heeb. 3479'
 Lans. 3518'
 Cong. 3800' Arb. 3838-42'
 5" @ 3841' TD 3842'
 FU 2750' oil S/30 boph
 Comp. draw down pot. 2853 bopd

COMPLETED

County Graham State Kansas

Sec. 10 (Blk. Twp.) 10 (Sur. Rge.) 21W Map No.

Operator Anderson-Prichard

Well No. 3 Farm Bartos

Elev. 2271 Location NW NW NE

			0		

330 Ft. From N Line NE

330 Ft. From W Line Quarter

1st. Report JAN 3 1951

Completion _____

Remarks _____

Spudding Date _____

Drlg. Data _____

drlg.

J. E. TYRA

County Graham State Kansas

Sec. 10 (Blk. 10) (Twp. 21W) (Sur. Rge.) 21W Map No.

Operator Anderson-Prichard

Well No. 3 Farm Bartos

Elev. 2271 Location NW NW NE

330 Ft. From N Line NE
 330 Ft. From W Line Quarter

COMPLETE

1st. Report

Completion FEB 14 1951

Remarks

Spudding Date 12-29-50

Drlg. Data Oil well TD 3842

8" @ 259 Heeb. 3479 Lans. 3518

Cong. 3800 Arb. 3838-42 5" @ 3841

TD 3842 FU 2750' oil S/ 30 boph

Comp. draw down pot. 2853 bopd

J. E. TYRA