

O. W. P. B.


Graham

KANSAS

SECTION 10 TOWNSHIP 10 RANGE 21 <sup>W</sup>

WELL NO. #7 James Bartos

COMPANY Skelly Oil

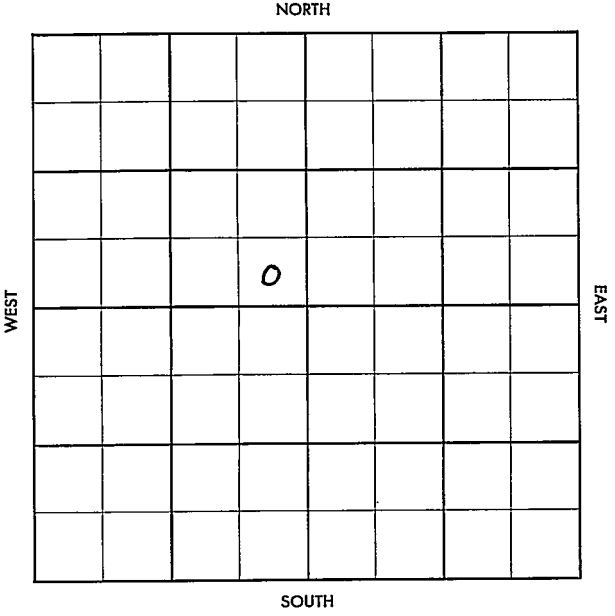

O. W. P. B. NO-RECORD Graham KANSAS


SEC. 10 TWP. 10 R. 21 W

WELL NO. # 7 James Bartos FARM

COMPANY Skelly Oil

CONTRACTOR

\_\_\_\_\_ Ft. from N. Line  
 \_\_\_\_\_ Ft. from S. Line  
 \_\_\_\_\_ Ft. from E. Line  
 \_\_\_\_\_ Ft. from W. Line

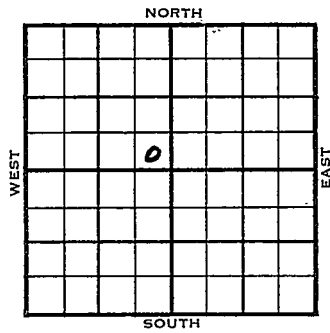

SE SE NW

1956 ELEVATION 2245 REPORT

O. W. P. B. NO-RECORD

1/11 OED 3826'  
 5" @ 3822 PB 3810' 24/3780-84  
 36/3788-94 250 A. B/12 GWPH 8 hr.  
 PB 3720' 60/3690-3700 4250 A  
 S/25 BO 1 BW 8 hr. PB 3650' 36/3632-38'  
 38', 2250 A B/20 GO 60 GWPH 6 hr.  
 PB 3600 36/3584-90 2250 A  
 S/4 BO 6 BW 8 hrs.  
 Comp. 54 BOPD 1 BW  
 Log tops: L. 3497', BKG 3720', C. 3778  
 Sh 3810', A. 3822'  
 TD 3826'

FIRST REPORT COMPLETED

# O. W. P. B.

FORM 513 REV. SUNRAY

OWPB

County Graham Elev. 2245  
 Sec. 10 Twp. 101 Rge. 21W  
 Company Skelly Oil  
 Farm Name James Bartos No. 7

TOPS	DEPTH	LOG	DATUM	Loc. in Sec.
Anh.				<b>SE SE NW</b>
Tr.				
<del>NO RECORD</del>				
L.		3497		Geol.
K.C.		3720		Contr.
B.K.C.		3778		
C.				Pool
M.				
M.				
K.				
Mz.				
Ma.				
V.	sh	3810		<div style="border: 1px solid black; padding: 5px; display: inline-block;"> <b>COMPLETE</b>                      JAN 11 '56                      0 ✓                 </div>
S.		3822		
S.				
A				
R.				
Pe.				
G.				
T.D.		3826		<b>FIRST REPORT</b>

Date Comm. OTD 3826 5" @ 3822 PB 3810  
24/ 3780-84 36/ 3788-94 250 A  
B/ 12 gwph 8 hr. PB 3720 60/ 3690-3700  
1050 A S/ 25 bo 1 bw 8 hr. PB 3650  
36/ 3632-38 2250 A B/ 20 go 60 gwph  
6 hr. PB 3600 36/ 3584-90 2250 A  
S/ 4 bo 6 bw 8 hr. Comp. 54 bo pd 1 bw