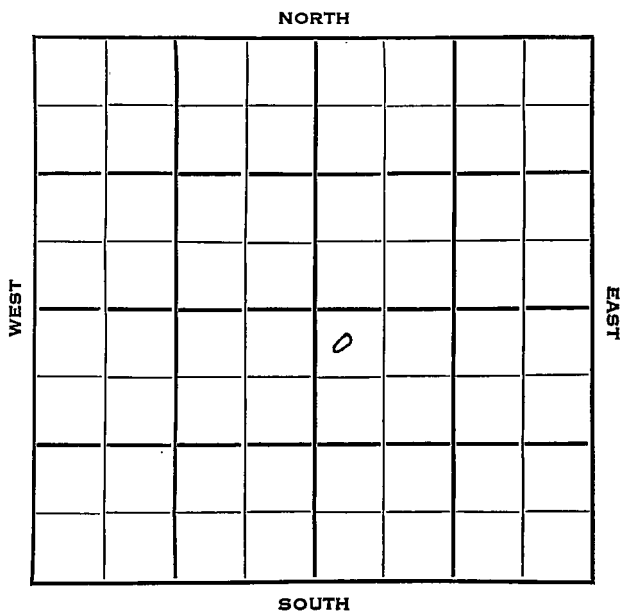


Section 10 Township 10 Range 21WWell No. #4 McIntyreCompany Jones, Shelburne & Farmer

Sec. 10 Twp. 10 R. 21 W

Well No. # 4 McIntyre Farm

Jones, Shelburne & Farmer Company

J-S-F Contractor


330 Ft. from N. Line

Ft. from S. Line

Ft. from E. Line

330 Ft. from W. Line

NW NW SE

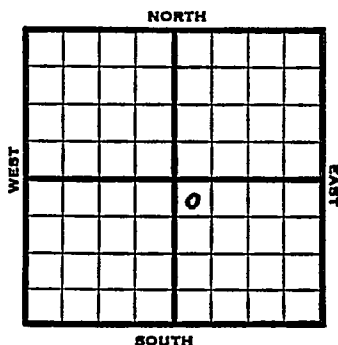

1953	Elev. 2230' REPORT
3/11	Location
3/19	8" @ 160 Anhy 1706' Drlg. 2842'
3/26	Heeb 3443, Tor 3463, Lans 3482, Arb 3789 DST 3789-94, 1 hr, 1380' oil, 1050A, FFP 600A, RTD 3794 5" @ 3789
4/2	CO 3794 FU 2000' oil S/10 BOPH plus S wtr. S/12 BOPH
4/9	NR
4/15	Spud 3-12-53 Oil Well TD 3794 8" @ 160 Anhy 1706, Heeb 3443, Tor 3463, Lans 3482, Arb. 3787 DST 3789-94, opn 1 hr., rec. 1380' oil, 1050# TD 3794 5" @ 3789, CO to 3794, FU 2000' oil S/10 boph & wtr., S/12 boph Comp. 324 bopd 57% wtr.

COMPLETED

County Graham State Kansas
 Sec. 10 (Blk.) 10 (Sur.) 21W Map No.
 Operator Jones, Shelburne & Farmer
 Well No. 4 Farm McIntyre
 Elev. _____ Location NW NW SE

FIRST REPORT


330 Ft. From N Line SE
330 Ft. From W Line Quarter
 1st. Report MAR 11 1953
 Completion _____
 Remarks _____
J-S-F - Contr.
 Spudding Date _____

Drig. Data _____

Location

J. G. McGEHEE

County Graham State Kansas
 Sec. 10 (Blk. 10 (Sur. 21W Map No.
 Operator Jones, Shelburne & Farmer
 Well No. 4 Farm McIntyre
 Elev. 2230 Location NW NW SE

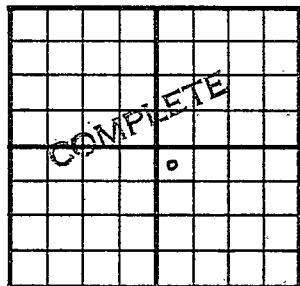

330 Ft. From N Line SE

330 Ft. From W Line Quarter

Ist. Report

Completion APR 15 1953

Remarks

J-S-F - Contr.

Spudding Date 3-12-53

Drlg. Data Oil well TD 3794

8" @ 160 Anhy 1706 Heeb. 3443

Tor. 3463 Lans. 3482 Arb. 3787

DST 3789-94 open 1 hr. Rec. 1380' oil

1050# TD 3794 5" @ 3789 CO to 3794

FU 2000' oil S/ 10 boph & wtr.

S/ 12 boph Comp. 324 bopd 57% wtr.

J. G. McGraw