


**O. W. P. B.**

Section 10 Township 10 Range 21 W

Well No. # 5 Bartos

Company Skelly Oil

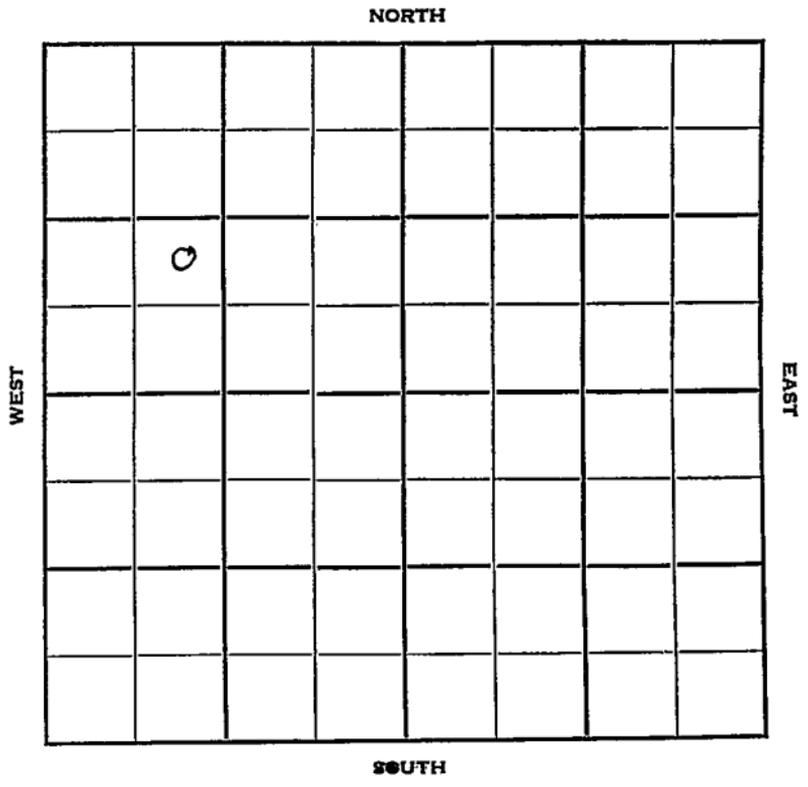

Sec. 10 Twp. 10 R. 21 W

Well No. # 5 Bartos Farm

Skelly Oil Company

Contractor

**Cooper Pool**


Ft. from N. Line

990 Ft. from S. Line

Ft. from E. Line

990 Ft. from W. Line

**NE SW NW**

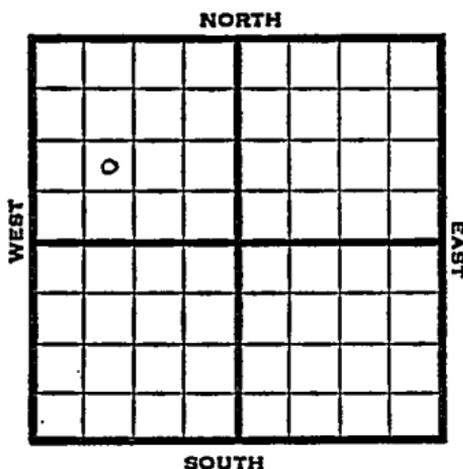

**1951** Elev. 2231' **REPORT**

**6/20** Spud 6-15-51  
10" @ 280'

**7/25** Spud 6-15-51  
Oil well TD 3801'  
10" @ 280 Heeb 3440' Lans 3480'  
Cong. 3750' Simp. 3781' Arb. 3794-97'  
5" @ 3795 TD 3801'  
FU 2500' oil 2 hr. P/97 BO 2 BW 6 hr.  
P/131 BO 5 BW 12 hrs.  
Comp. 281 BOPD 34% water

**COMPLETED**

**O. W. P. B.**

**1954**  
**9/29** Oil Well TD 3801'  
Lans 3474', Arb. 3794'  
OTD 3801'  
5" @ 3795'  
Perf 90/3668-76, 1500A, swb 1 BOPH + 5% wtr, 6 hrs.  
PB 3660', 90/3646-50, 500A, swb 40 BO, 7 hrs., 1000A - no test, PB 3630', 63/3609-16, 2000A, swb 20 BO, 5 hrs. + 5% wtr, PB 3580, 24/3559-67, test 3 BWPH 12 hrs., sq perfs 3559-67 & CO 3696  
P 39 BO + 4 BWPD

**FIRST REPORT / COMPLETED**



County Graham State KansasSec. 10 (Blk.  
Twp.) 10 (Sur.  
Rge.) 21W Map No.Operator Skelly OilWell No. 5 Farm BartosElev. 2231 Location NE SW NW


990 Ft. From S Line NW990 Ft. From W Line Quarter

Ist. Report

Completion JUL 25 1951Remarks Cooper PoolSpudding Date 6-15-51Drlg. Data Oil well TD 380110" @ 280 Heeb. 3440 Lans. 3480Cong. 3750 Simp. 3781 Arb. 3794-975" @ 3795 TD 3801 FU 2500' oil 2 hr.P/ 97 bo 2 bw 6 hr. P/ 131 bo 5 bw12 hr. Comp. 281 bopd 34% water

J. E. TYRA

