

Section 10 Township 10 Range 21 WWell No. # 2 McIntireCompany Jones, Shelborne & Farmer

NORTH

WEST

							0

EAST

SOUTH

Graham

KANSAS
21 W

Sec. 10 Twp. 10 R. 21 W

Well No. # 2 McIntire Farm

Jones, Shelborne & Farmer Company

J-S-F Contractor

Cooper Pool


330 Ft. from N. Line

Ft. from S. Line

330 Ft. from E. Line

Ft. from W. Line

NE NE SE

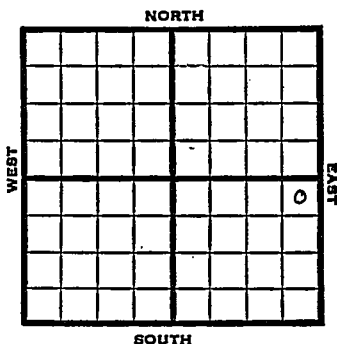

1951

Elev. 2277' REPORT

9/26


Spud 9-22-51
8" @ 160 WOC

10/17

Spud 9-22-51
D&A TD 3923
8" @ 160
Heeb. 3486 Lan. 3526
BKC 3742 Marm 3764
Cong. 3799 Arb. 3914
TD 3923
D&A $\frac{2277}{1646}$

ABANDONED

County Graham State Kansas
 Sec. 10 (Blk.) 10 (Sur.) 21W Map No.
 Operator Jones, Shelborne & Farmer
 Well No. 2 Farm McIntire
 Elev. _____ Location NE NE SE

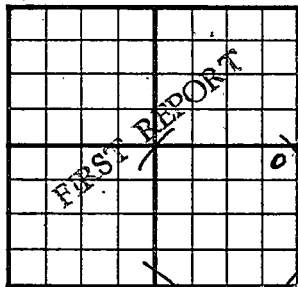


330 Ft. From N Line SE
330 Ft. From E Line Quarter
 Ist. Report SEP 26 1951
 Completion _____
 Remarks J-S-F - Contr.
 Spudding Date 9-22-51

Drlg. Data Cooper Pool
8" @ 160 WOC

J. E. TYRA

County Graham State Kansas
 Sec. 10- (Blk.) 10 (Sur.) 21W Map No. _____
 Operator Jones, Shelborne & Farmer
 Well No. 2 Farm McIntire
 Elev. 2277 Location NE NE SE

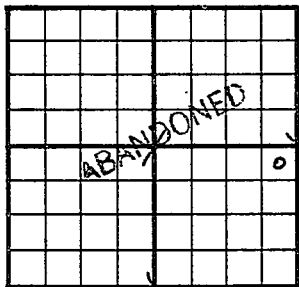

330 Ft. From N Line SE
330 Ft. From E Line Quarter
 Ist. Report _____
 Completion OCT 17 1951
 Remarks Cooper Pool
J-S-F - Contr.
 Spudding Date 9-22-51

Drig. Data D & A TD 3923
8" @ 160 Heeb. 3486 Lans. 3526
B KC 3742 Marm. 3764 Cong. 3799
Arb. 3914 TD 3923

D & A

J. E. TYRA