


Section 11 Township 10 Range 12-W

Well No. #1 Applegate

Company G. B. Davis

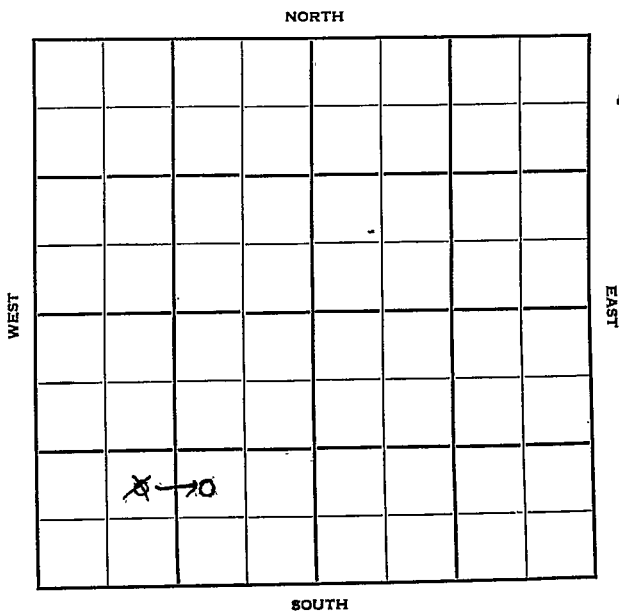

Osborne

KANSAS

Sec. 11 Twp. 10 R. 12W ✓

Well No. #1 Applegate Farm

C. B. Davis Company

Stearns Contractor

 Ft. from N. Line


990' Ft. from S. Line

990 Ft. from E. Line

~~990'~~ Ft. from W. Line

~~NE SW SW~~

NW SE SW

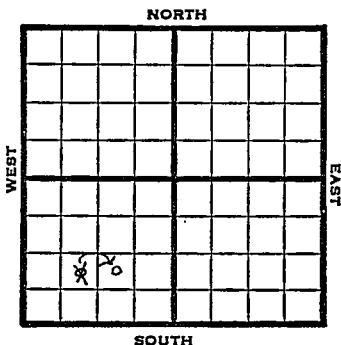

1950 Elev. 1744' REPORT

5/10 10" @ 110'
Anhy 772'
Drlg. 2645'

6/7 10" @ 110'
Anhy 772'
Heeb 2925'
KC 2980'
TD 3221'
D&A TD 3221'

ABANDONED

Map No. _____ Sec. 11 Twp. 10 R. 12W

Well No. 1 Applegate

C. R. Davis Company

Stearns Contractor

NE SW ST

SECTION PLAT

FIRST REPORT			
0			

_____ Ft. from N. Line

990 Ft. from S. Line

_____ Ft. from E. Line

990 Ft. from W. Line

Osborne

Location _____

Rig up _____

Drilling and Remarks:

101" @ 110

Anhy 772

drlg. 2645

RECORD

Cased _____ in., _____ ft.

Sand _____

Gas _____

Oil _____

Total Depth _____

PRODUCTION

1st 24 hrs. Nat. _____

1st 24 hrs. after shot _____

Gas _____ Cu. Ft.

Dry Hole _____

Abandoned _____

Date

MAY 19 1950

J. E. TYRA Scout

Map No. _____ Sec. 11 Twp. 10 R. 12WWell No. 1 Applegate

C. B. Davis _____ Company

CORRECTION_____
ContractorN^W SE SW

SECTION PLAT

	o		

_____ Ft. from N. Line

990 Ft. from S. Line990 Ft. from E. Line

_____ Ft. from W. Line

Osborne

Location _____

Rig up _____

Drilling and Remarks:

Reported NE SW SW

RECORD

Cased _____ in., _____ ft.

Sand _____

Gas _____

Oil _____

Total Depth _____

PRODUCTION

1st 24 hrs. Nat. _____

1st 24 hrs. after shot _____

Gas _____ Cu. Ft.

Dry Hole _____

Abandoned _____

Date

JUN 7 1950 19

TYRA

Scout

Kansas

Map No. _____ Sec. 11 Twp. 10 R. 12WWell No. 1 ApplegateC. B. Davis Company

Contractor


NW SE SW

E. 1744
SECTION PLAT

_____ Ft. from N. Line

990 Ft. from S. Line990 Ft. from E. Line

_____ Ft. from W. Line

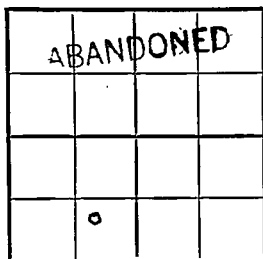

Osborne

Location _____

Rig up _____

Drilling and Remarks:

10" @ 110
 Andy 772
 Hub 2925
 K.C. 2980
 T.D. 3221
 D & A

RECORD

Cased _____ in., _____ ft.

Sand _____

Gas _____

Oil _____

Total Depth 3221

PRODUCTION

1st 24 hrs. Nat. _____

1st 24 hrs. after shot _____

Gas _____ Cu. Ft.

Dry Hole _____

Abandoned _____

Date

JUN 7 1950 19 J. E. TYRA Scout