


SECTION 11 TOWNSHIP 10 RANGE 15W

WELL NO. #1 Meyer

COMPANY D.R. Lauck

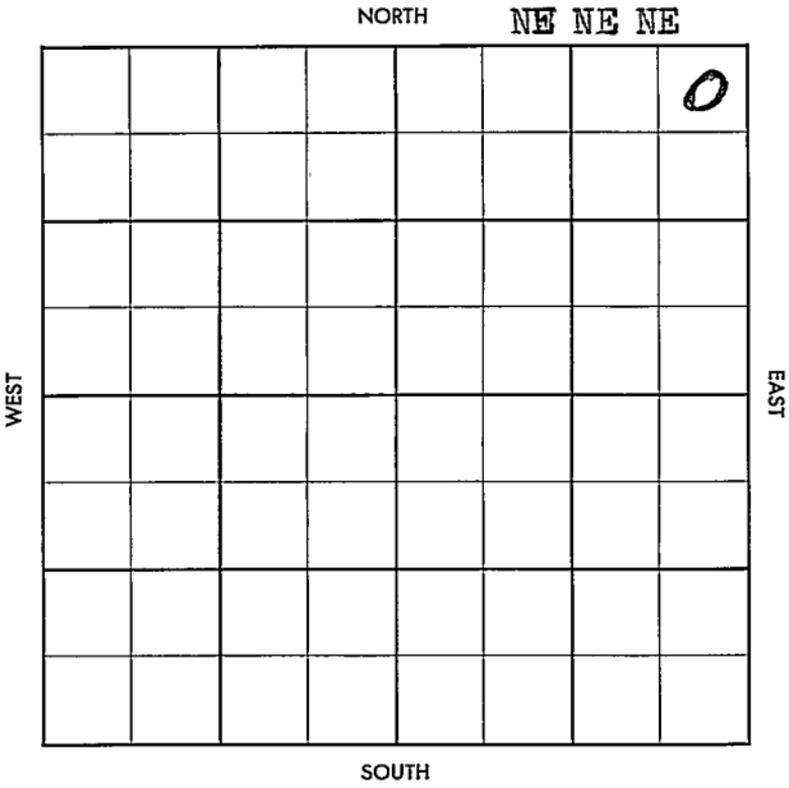

~~WILDCAT~~


FORM 513 SUNRAY

County	Osborne	Elev.	
Sec.	11	Twp.	10
		Rgs.	15W
Company	D. R. Lauck		
Farm Name	Meyer	No.	1

TOPS	DEPTH	LOG	DATUM	Loc. in Sec.																
Anh.				NE NE NE																
Tr.																				
H.																				
Tr.																				
Dg.				Geol.																
Bl.																				
L.				Contr.																
K.C.																				
B.K.C.				Co. Tools																
Ce.																				
C.				Pool																
M.																				
M.				Wildcat																
K.																				
Mz.				<table border="1" style="width: 100%; border-collapse: collapse;"> <tr> <td style="width: 25%;"></td> <td style="width: 25%;"></td> <td style="width: 25%;"></td> <td style="width: 25%;"></td> </tr> <tr> <td colspan="4" style="text-align: center;">FIRST REPORT</td> </tr> <tr> <td colspan="4" style="text-align: center;">JUN 26 '57</td> </tr> <tr> <td></td> <td></td> <td></td> <td></td> </tr> </table>					FIRST REPORT				JUN 26 '57							
FIRST REPORT																				
JUN 26 '57																				
Mo.																				
V.																				
S.																				
S.																				
A.																				
R.																				
Pf.																				
G.																				
T.D.																				

Date Comm. 6-20-57 Carter - DHM

8" @ 213/165, Drlg. 2460

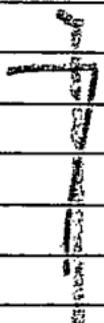

County Osborne Elev. 1858 KB
 Sec. 11 Twp. 10 Rgs. 15W
 Company D. R. Lauck
 Farm Name Meyer No. 1

TOPS	DEPTH	LOG	DATUM	Loc. in Sec.
Anh.				NE NE NE
TP.				
H.	3031	3028		
Tr.	3053	3051		
Dg.				
Bl.				
L.	3081	3078		
K.C.				Geol.
B.K.C.				Contr.
Ce.				Co. Tools
C. <u>sd</u>	3467			Pool
M. <u>cherty c</u>	3480			Wildcat
M.				
K.				
Mz.				
Ma.				
V.	3612	3609		
S. <u>SA</u>	3697	3697		
S.				
A.	3722	3722		
R.				
PE.				
G.				
TD.	3775			

ABANDONED

JUL 3 57

Date Comm. 6-20-57 Carter - DHM
 8" @ 213/165, Drlg. 2460 " 3 57

DST 3037-67 1hr sec 5' Md
BHP 240/20"

D.E.A.

Co.
Lse.
No.
Sec.
T.
R.