

DX 78-1


Rooks

KANSAS

Section 11 Township 10 Range 19W

Well No. #3 Husted

Company J. F. Darby Oil

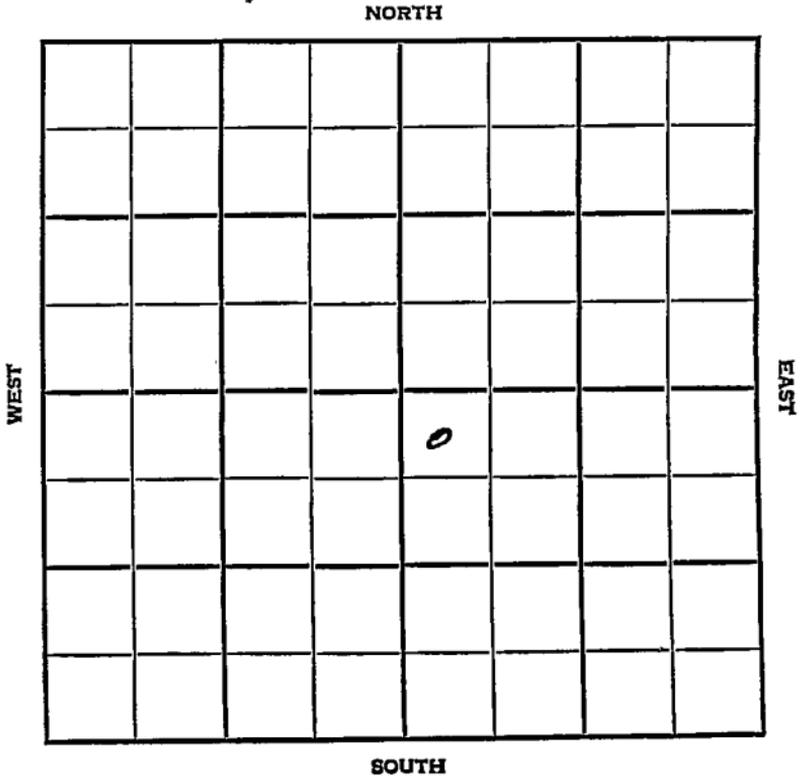

Rooks

KANSAS

SEC.	TWP.	R.
11	10	19 W

WELL NO.

3 Husted

FARM

COMPANY

J. F. Darby Oil

CONTRACTOR

Iron Drlg.
Vohs Pool


330 Ft. from N. Line

Ft. from S. Line

Ft. from E. Line

330 Ft. from W. Line

NW NW SE

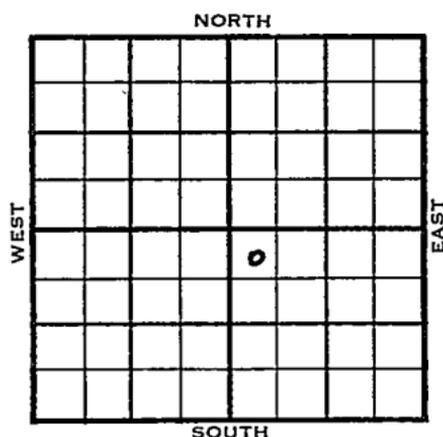

ELEVATION

REPORT

1955

2092'

5/25

Spud 4-21-55 Oil well TD 3604'
 Anhy 1460' 8" @ 1464 Top. 3028
 DST 3182-98 open 1 hr rec 160' muddy
 wtr. 100# Heeb 3241' Tor 3261'
 Lans 3283'
 DST 3322-58 open 1 hr rec 170' wtr.
 150#
 DST 3432-63, open 42 min, rec 5' mud
 Off. B KC 3500' Cong 3526'
 Simp. 3570'
 DST 3572-81, failed.
 DST 3569-81 open 1 hr rec 18' mud Off
 Arb. 3599
 DST 3599-3602 open 1 hr rec 11' mud
 910# TD 3603 5" @ 3602
 DD 3604 S/3 GOPH 4 hr. 1500 A
 S/32 BO 14 hr.
 Comp. 83 BOPD

FIRST REPORT

↓
 COMPLETED

County _____ Rooks _____ State **Kansas**
 Sec. 11 (Blk. Twp.) (10) (Sur. Rge.) 19W Map No. _____
 Operator J. F. Darby Oil
 Well No. 3 Farm Husted
 Elev. 2092 Location NW NW SE

330 Ft. From N Line SE
 330 Ft. From W Line Quarter
 1st. Report MAY 25 1955
 Completion _____
 Remarks Vohs Pool
 Iron Drlg. - Contr.
 Spudding Date 4-21-55

Drlg. Data Oil well TD 3604
 Anhy 1460 8" @ 1464 Top. 3028
 DST 3182-98 open 1 hr. Rec. 160' muddy
 wtr. 100 # Heeb. 3241 Tor. 3261
 Lans. 3283 DST 3322-58 open 1 hr.
 Rec. 170' wtr. 150# DST 3432-63
 open 42 min. Rec. 5' mud 0#
 B KC 3500 Cong. 3526 Simp. 3570
 DST 3572-81 failed DST 3569-81
 open 1 hr. Rec. 18' mud 0#
 Arb. 3599 DST 3599-3602 open 1 hr.
 Rec. 11' mud 910# TD 3603 5" @ 3602
 DD 3604 S/ 3 goph 4 hr. 1500 A
 S/ 32 bo 14 hr. Comp. 83 bopd