


KANSAS

Rocks

Section 11 Township 10 Range 19-W

Well No. #3 Pirotte est.

Company British American

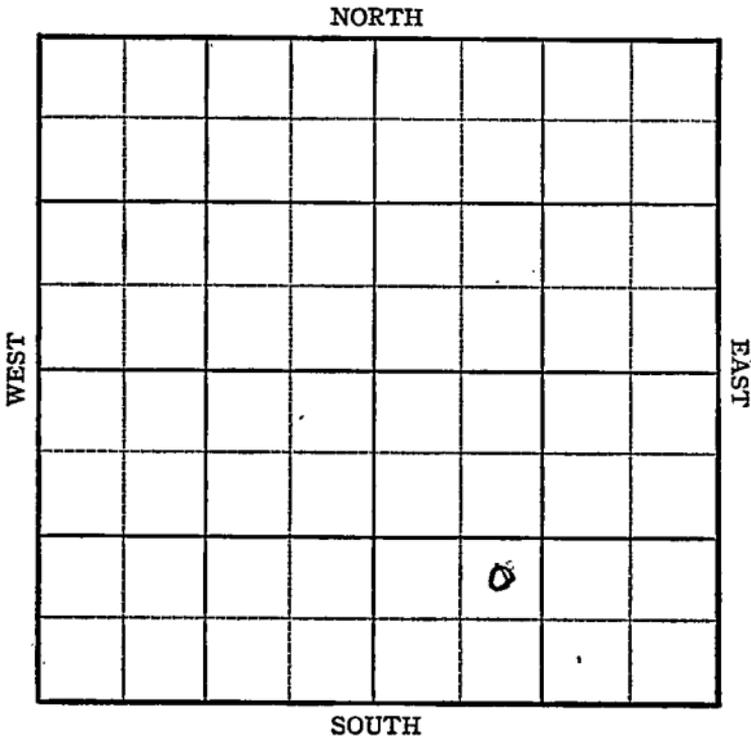

KANSAS

Rooks County

Sec. 11 Twp. 10 R. 19W

Well No. #3 Pirotte Est. Farm

British American Company


Vohs

_____ Ft. from N. Line

990 Ft. from S. Line

_____ Ft. from E. Line

990 Ft. from W. Line

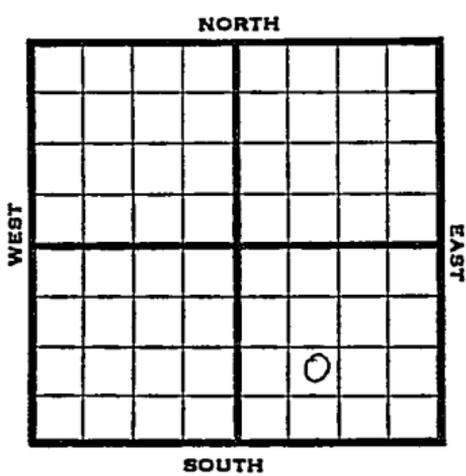

NE SW SE

1946 Elev. 2089' REPORT

- 2/20 Drlg. 460'
- 2/28 10" - 1445'
Drlg. 2525'
- 3/7 Topeka 3006' Lans 3254'
Drlg. 3476'
- 3/14 Cong 3509' Simp 3552'
Arb. 3579' T.D. 3582' 5" - 3580'
48 shots 3339-58'
800' oil 1 hour.
- 3/20 Arb. 3579
Lans 3259
5" @ 3580
Perf. Lans. 500 acid.
TD 3582'
Pump 1048 Pot.
Grav. 35.0

COMPLETED

