



Sec. 11 Twp. 10 R. 20 W

Well No. 1 Croffoot Est. Farm \_\_\_\_\_

C & G Company

Wildcat C & G-Contr.


NORTH

\_\_\_\_\_ Ft. from N. Line

330 Ft. from S. Line

\_\_\_\_\_ Ft. from E. Line

330 Ft. from W. Line

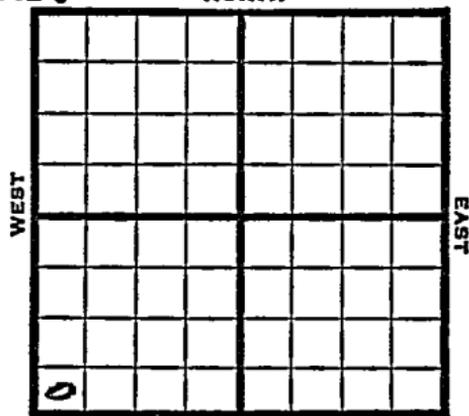

SW/C

SOUTH

1949 Elev 2209' REPORT

9/28 Loc.

10/5 "

10/12 8" @ 245'

Drlg 480'

10/19 Lansing 3477'

Drlg 3515'

10/26 Arbuckle 3771'

TD 3775'

5" @ 3773'

11/1 "

11/9 TD 3777'

Acid 4000'

Swb 5 bbls oil PH, 5 hrs.

11/16 "

11/23 "

11/30 TD 3777'

Arb. 3771'

5" @ 3773'

4000 acid

Pump 149 Oil Pot

30° Gr.

Comp

**COMPLETED**

Map No. \_\_\_\_\_ Sec. 11 Twp. 10 R. 20W

Well No. 1 Croffoot Est.

C & G Company

C & G Contractor

SW/C

FIRST REPORT  
SECTION-FLAT

\_\_\_\_\_ Ft. from N. Line

330 Ft. from S. Line

\_\_\_\_\_ Ft. from E. Line

330 Ft. from W. Line


Rooks County

RECORD

Location X

Cased \_\_\_\_\_ in., \_\_\_\_\_ ft.

Rig up \_\_\_\_\_

Sand \_\_\_\_\_

Drilling and Remarks:

Gas \_\_\_\_\_

Oil \_\_\_\_\_

Total Depth \_\_\_\_\_

PRODUCTION

1st 24 hrs. Nat. \_\_\_\_\_

1st 24 hrs. after shut \_\_\_\_\_

Gas \_\_\_\_\_ Cu. Ft.

Dry Hole \_\_\_\_\_

Abandoned \_\_\_\_\_

Date

SEP 28 1949 19

S. J. LEWIS Scout

Map No. \_\_\_\_\_ Sec. 11 Twp. 10 R. 20W

Well No. 1 Croffoot Est.

C & G Drlg. Company

COMPLETE Contractor

SW/C

*E. 2209*  
SECTION PLAT

\_\_\_\_\_ Ft. from N. Line

330 Ft. from S. Line

\_\_\_\_\_ Ft. from E. Line

330 Ft. from W. Line


Rooks County

*SAR*  
7

RECORD

Location \_\_\_\_\_

Cased \_\_\_\_\_ in., \_\_\_\_\_ ft.

Rig up \_\_\_\_\_

Sand \_\_\_\_\_

Drilling and Remarks:

Gas \_\_\_\_\_

Oil \_\_\_\_\_

*CR 43771*  
*5' @ 3773*  
*4000 acd*  
*Prod 149 oil Bx.*  
*380 cu*

Total Depth 3777

PRODUCTION

1st 24 hrs. Nat. \_\_\_\_\_

1st 24 hrs. after shot \_\_\_\_\_

Gas \_\_\_\_\_ Cu. Ft.

Dry Hole \_\_\_\_\_

Abandoned \_\_\_\_\_

Date

NOV 30 1949 19

S. I. LEW!

Scout