


Section 11 Township 10 Range 20WWell No. #1 CrowfootCompany I. O. Miller

NORTH

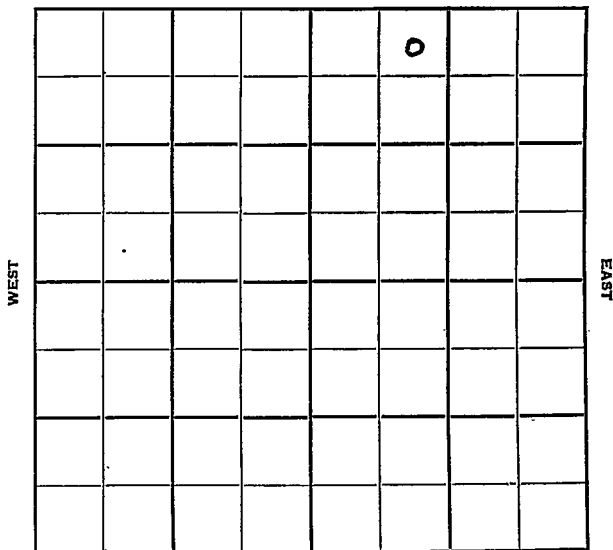

SOUTH

Rooks

KANSAS

II

10

20W

Sec. _____ Twp. _____ R. _____

#1 Crowfoot

Well No. _____ Farm _____

I. O. Miller

Company

Virginia Drlg.

_Contractor

330

_Ft. from N. Line


Ft. from S. Line

Ft. from E. Line

990

_Ft. from W. Line

NE NW NE

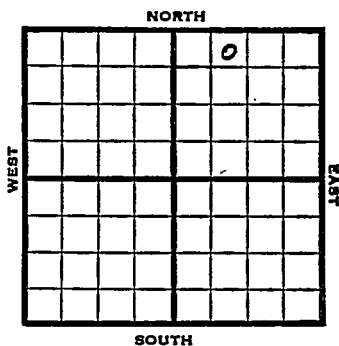

L952

File v. 2220: REPORT

11/19 Spud 11-12-52
8" @ 210
Dr1g. 2670'

11/27 D&A

12/3 Spud 11-12-52
D&A
TD 3825
8" @ 210'
Top. 3243, Heeb 3456, Tor 3477,
Lans 3493, B KC 3712, Cong
3777
TD 3825
D&A

ABANDONED

County Rooks State Kansas
 Sec. 11 (Blk. 10 (Sur. 20W Map No.
 Twp.) Rge.)
 Operator I. O. Miller
 Well No. 1 Farm Crowfoot
 Elev. Location NE NW NE

FIRST REPORT

330 Ft. From N Line NE990 Ft. From W Line Quarter1st. Report NOV 19 1952

Completion

Remarks

Virginia Drlg. - Contr.Spudding Date 11-12-52

Drlg. Data

8" @ 210 drlg. 2670

J. G. McGEHEE

County	Rooks	State	<u>Kansas</u>
--------	-------	-------	---------------

Sec. 11 (Blk. Twp.) 10 (Sur. Rge.) 20W Map No.

Operator I. O. Miller

Well No. 1 Farm Crowfoot

Elev.	2220	Location	NE NW NE
-------	------	----------	----------

330 Ft. From N Line NE

990 Ft. From	W Line	Quarter
--------------	--------	---------

1st. Report

Completion DEC 3 1952

Remarks

Virginia Drlg. - Contr.






