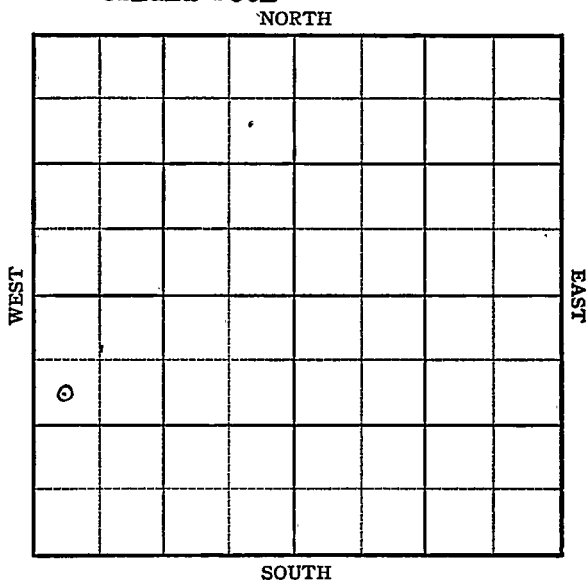


Section 11 Township 10 Range 20-WWell No. #2 Croffoot Est.Company C & G Drlg
Berland Pool

KANSAS

Rooks

Sec. 11 Twp. 10 R. 20-W

Well No. #2 Croffoot Est. Farm

C & G Drlg

Company

Berland Pool (C & G Drlg. Contr)

Contractor


990 Ft. from N. Line

Ft. from S. Line

Ft. from E. Line

330 Ft. from W. Line

SW NW SW

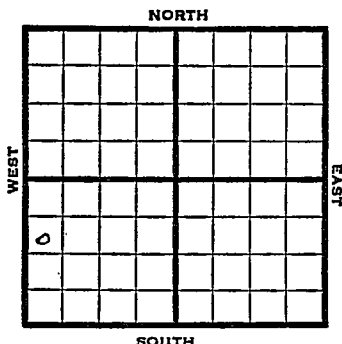

1949

REPORT

11/16 Location
11/23 "
11/29 "
12/7 "
12/14 8" @ 245'
Drlg. 2185'
12/21 Drlg 3690'
12/28 Lansing 3496'
Arb. 3796'
TD 3800
5"@ 3797'
2/8 TD 3800'
8"@ 245'
5"@ 3797'
Hub 3460'
Lans 3496'
Cong 3758'
Simp 3776'
Arb. 3796'
P 186 BOPD
Comp

COMPLETED

Map No. _____ Sec. 11 Twp. 10 R. 20W

Well No. 2 Croffoot Est.

C & G Drlg. _____ Company

C & G Drlg. _____ Contractor

SW NW SW


**FIRST REPORT
SECTION PLAT**

990 Ft. from N. Line

_____ Ft. from S. Line

_____ Ft. from E. Line

330 Ft. from W. Line

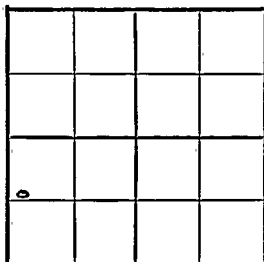

Rooks County

Location _____ X _____

Rig up _____

Drilling and Remarks:

RECORD

Cased _____ in., _____ ft.

Sand _____

Gas _____

Oil _____

Total Depth _____

PRODUCTION

1st 24 hrs. Nat. _____

1st 24 hrs. after shot _____

Gas _____ Cu. Ft.

Dry Hole _____

Abandoned _____

Date

NOV 16 1949

19

S. J. LEWIS

Scout

Map No. _____ Sec. 11 Twp. 10 R. 20WWell No. 2 Croffoot Est.

C & G Drlg.

Company

Contractor

SW NW SW

SECTION PLAT

990 Ft. from N. Line

_____ Ft. from S. Line

_____ Ft. from E. Line

330 Ft. from W. Line

Rooks County

Location _____

Rig up _____

Drilling and Remarks:

8" @ 2455" @ 3797Hub 3460Lane 3496Cong 3758Sings 3776Ant 3796

RECORD

Cased _____ in., _____ ft.

Sand _____

Gas _____

Oil _____

Total Depth 3800

PRODUCTION

1st 24 hrs. Nat. _____

1st 24 hrs. after shot _____

Gas _____ Cu. Ft.

Dry Hole _____

Abandoned _____

P 186 BOPD

Date

FEB 8 1950

19

J. E. TYRA

Scout