


Section 11 Township 10 Range 20W

Well No. 2 - Crowfoot

Company I.O. Miller

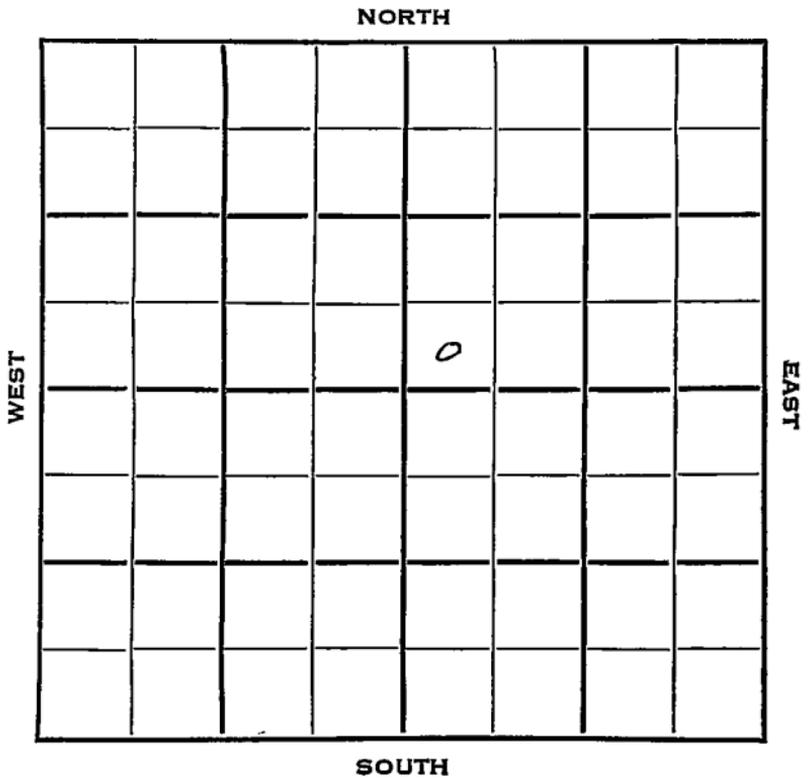



Sec. 11 Twp. 10 R. 20 W

Well No. # 2 Crowfoot Farm

I. O. Miller Company

Virginia Drlg. Contractor


_____ Ft. from N. Line

330 Ft. from S. Line

_____ Ft. from E. Line

330 Ft. from W. Line

SW SW NE

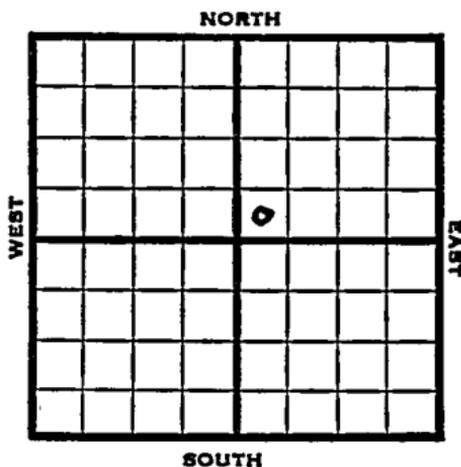

1952	Elev. 2225' REPORT
12/30	RUR
1/1	RUR
1/8	8" @ 197 KC 3477 Ø3523
1/15	BKC 3691, Cong 3728, Simp 3747, Arb. 3772 RTD 3775 5" @ 3773
1/22	NR
1/29	"
2/5	NR
2/11	Oil Well TD 3777 8" @ 197 Heeb 3439, Tor 3461, KC 3477, B KC 3691, Cong 3728, Simp 3747, Arb 3772 TD 3775 5" @ 3773 CO to 3775 500A S/25 boph DD 3777 Comp 3000 hoph

COMPLETED

