


DX 78-1

Section 11 Township 10 Range 20WWell No. 4 CroffootCompany L. O. Miller

NORTH

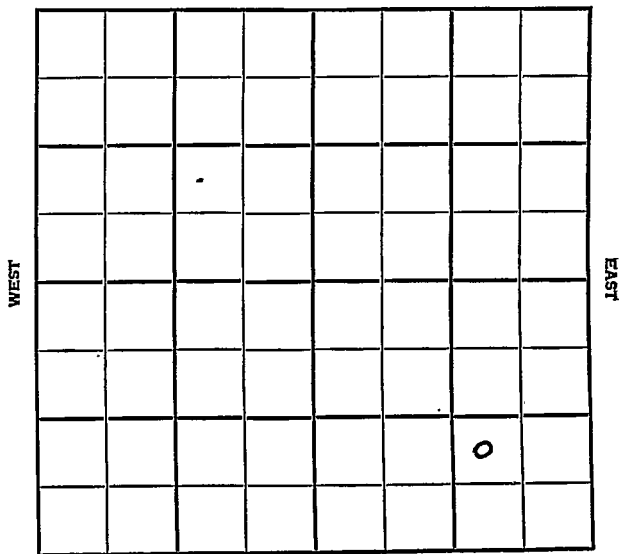

SOUTH

Rooks

SEC.	TWP.	R.
11	10	20W

WELL NO.

#4 Croffoot

FARM

COMPANY

I.O. Miller

CONTRACTOR

Virginia Drlg.

Marcotte Pool

_____ Ft. from N. Line


990

_____ Ft. from S. Line

990

_____ Ft. from E. Line


_____ Ft. from W. Line

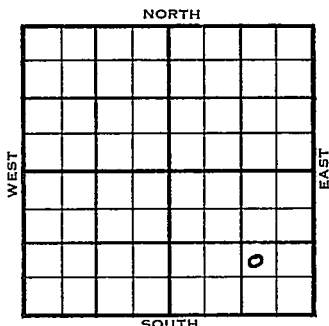

NW SE SE

	ELEVATION	REPORT
1954	2222'	
5/26	Spud 5-20-54 8" @ 205' Drlg 3205'	
6/2	Heeb 3454' Tor 3476 Lans 3492 B-KC 3707 Cong 3733 Simp 3756 Arb. 3799' DST 3800-3803, 1 hr, 16' SOCM, No wtr. 170# RTD 3803 5" @ 3800	
6/9	CO 3803 DD 3804 500 A 8 Go + 8 GWPH DD 3806 1000 A No help DD 3812 3000 A S/2 BOPH	
6/23	POP	
6/30	NR	
7/7	"	
7/28	Spud 5-20-54 Oil well TD 3812 8" @ 205' Heeb 3454 Tor. 3476' Lans. 3492 B-KC 3707 Cong. 3733 Simp. 3756 Arb. 3799 DST 3800-3803 open 1 hr rec 16' SOCM 170# TD 3803 5 1/2" @ 3801 Co to 3803 DD 3804 500 A 8 Go 8 GWPH DD 3806 1000 A DD 3812 3000 A S/2.16 BOPH S/2 1/2 BO 1/2 BW Comp. 75 BOPD 10% wtr.	

COMPLETED

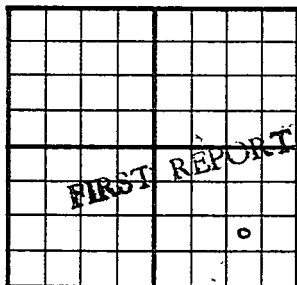County Rooks State KansasSec. 11 (Blk. Twp.) 10 (Sur. Rge.) 20W Map No.Operator I. O. MillerWell No. 4 Farm CroffootElev. Location NW SE SE990 Ft. From S Line SE990 Ft. From E Line Quarter1st. Report MAY 26 1954

Completion

Remarks

Virginia Drlg. - Contr.Spudding Date 5-20-54Drlg. Data Marcotte Pool8" @ 205 drlg. 3205

J. G. McGEHEE

