

Sec. 11 Twp. 10 R. 20W

Well No. #5 Croffoot Farm

C & G Drlg. Company


Marcotte Pool Contractor

Ft. from N. Line

330' Ft. from S. Line

990' Ft. from E. Line

Ft. from W. Line

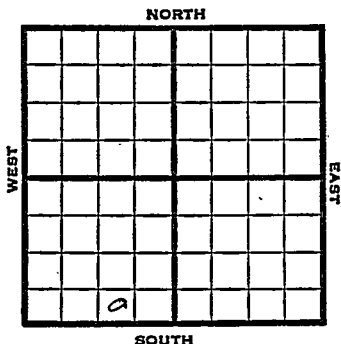

SW SE SW

1951 Elev. 2239' REPORT

6/6 Location

7/18 Spud 6-9-51

Oil well TD 3803' 8" @ 190
 Anhy 1687' Lans 3506' B KC 3720'
 Cong. 3758' Simp. 3779' Arb. 3797-
 3800' 5" @ 3798' TD 3803'
 B/ 1 BOPH 1000 A B/4 BOPH
 Comp. 151 BOPD

COMPLETED

