FORM 51


Rooks

KANSAS

Section 11 Township 10 Range 20W

Well No. 6 - Croffoot

Company C.& G. Drlg

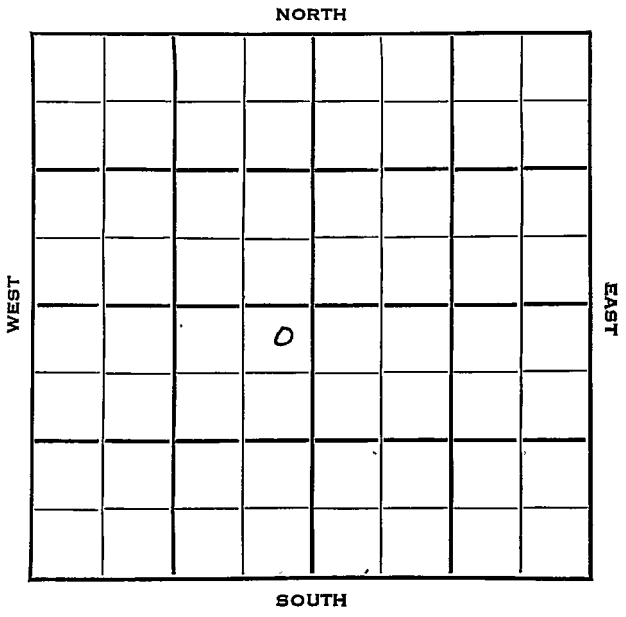

FORM 252-B

Rooks **KANSAS** ✓

Sec. 11 Twp. 10 R. 20W

Well No. #6 Croffoot Farm

C & G Drlg. Company

C & G Drlg. Contractor


330 Ft. from N. Line

Ft. from S. Line

330 Ft. from E. Line

Ft. from W. Line

NE NE SW

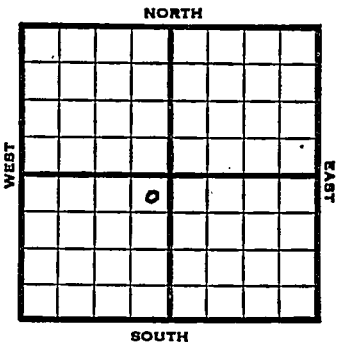

1953	REPORT
	Elev. 2234
1/21	Spud 1-17-53 8" @ 164 Drlg. 2370
1/29	Heeb 3441, Tor 3462, Lans 3492 DST 3562-70, 1/2 hrs., 590' gas, 180' free oil, 1280# B KC 3692, Cong 3724, Simp 3743, Arb. 3765 RTD 3767 5" @ 3767
2/5	DD 3768' S/62 BOPH 1000' off btm 2 hrs. 500 A
2/12	P/25 BOPH
2/18	Spudding Date 1/17/53 Oil Well TD 3768 8" @ 164 Heeb. 3441 Tor. 3462 Lans. 3492 DST 3562-70 open ½ hr. Rec. 590' gas 180' fre oil 1280# B K C 3692 Cong. 3724 Simp. 3743 Arb. 3765 TD 3767 5" @ 3767 DD 3768 S/62 boph 500 A P/25 boph Comp. 3000 bopd

COMPLETED

FORM 275 FOR SALE BY KANSAS BLUE PRINT CO.


County Rooks State Kansas

Sec. 11 (Blk. Twp.) 10 (Sur. Rge.) 20W Map No.

Operator C & G Drlg.

Well No. 6 Farm Croffoot

Elev. Location NE NE SW

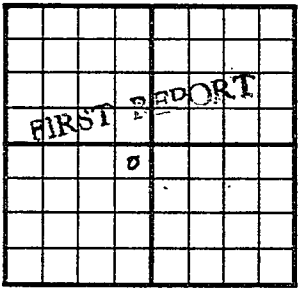

330 Ft. From N Line SW

330 Ft. From E Line Quarter

1st. Report JAN 21 1953

Completion

Remarks

C & G Drlg. - Contr.

Spudding Date 1-17-53

Drlg. Data

8" @ 164 drlg. 2370

J. G. McGEHEE

FORM 275 FOR SALE BY KANSAS BLUE PRINT CO.


County Rooks State Kansas

Sec. 11 (Blk. Twp.) 10 (Sur. Rge.) 20W Map No.

Operator C & G Drlg.

Well No. 6 Farm Croffoot

Elev. 2234 Location NE NE SW

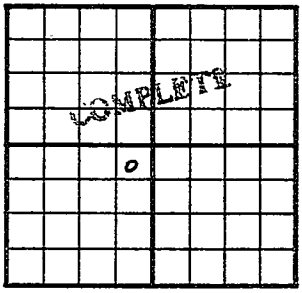

330 Ft. From N Line SW

330 Ft. From E Line Quarter

1st. Report

Completion FEB 1 8 1953

Remarks

C & G Drlg. - Contr.

Spudding Date 1-17-53

Drlg. Data Oil well TD 3768

8" @ 164 Heeb. 3441 Tor. 3462

Lans. 3492 DST 3562-70 open ½ hr.

Rec. 590' gas 180' free oil 1280#

B KC 3692 Cong. 3724 Simp. 3743

Arb. 3765 TD 3767 5" @ 3767 DD 3768

S/ 62 boph 500 A P/ 25 boph

Comp. 3000 bopd

J. G. McGEHEE