FORM 51

Rooks KANSAS

Section 11 Township 10 Range 20 W

Well No. # 7 Croffoot

Company C & G Drlg.

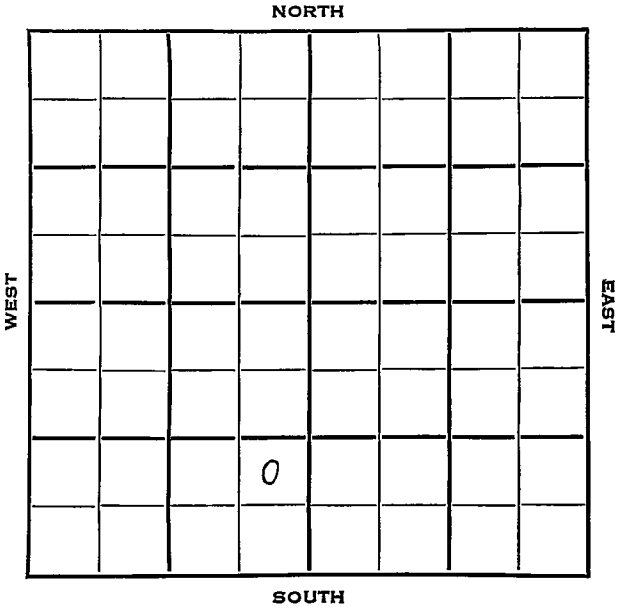

Rooks KANSAS

SEC.	TWP.	R.
11	10	20 W

WELL NO.

7 Croffoot FARM

COMPANY

C & G Drlg.

CONTRACTOR

C & G Drlg.

_____ Ft. from N. Line

990 Ft. from S. Line

330 Ft. from E. Line

_____ Ft. from W. Line

NE SE SW

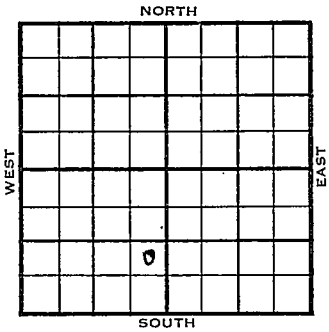

1953	ELEVATION 2238' REPORT
12/22	Spud 12-19-53 8" @ 167 Drlg. 2300'
1954 1/6	Anhy 1688' Heeb 3461' B KC 3715' Cong. 3745' Rew Arb. 3789' Arb. 3795' RTD 3803' 5" @ 3798'
1/13	CO 3803' S/15 BFPH 50% wtr.
1/20	NR
2/10	Spud 12-19-53 Oil well TD 3803 8" @ 167 Anhy 1688 Heeb 3461 Tor. 3479 Lans 3497 B KC 3715 Cong. 3745 ReArb. 3789 Arb. 3795 TD 3803 5" @ 3798 CO to 3803 S/15 BFPH 50% wtr. Comp. 99 BOPD 65% wtr. **COMPLETED**

DX-78

FORM 275 FOR SALE BY KANSAS BLUE PRINT CO.

County Rooks State Kansas

Sec. 11 (Blk. Twp.) 10 (Sur. Rge.) 20W Map No.

Operator C & G Drlg.

Well No. 7 Farm Croffoot

Elev. Location NE SE SW

FIRST REPORT

990 Ft. From S Line SW

330 Ft. From E Line Quarter

1st. Report DEC 22 1953

Completion

Remarks

C & G Drlg. - Contr.

Spudding Date 12-19-53

Drlg. Data

8" @ 167 drlg. 2300

J. G. McGEHEE

FORM 275 FOR SALE BY KANSAS BLUE PRINT CO.

County Rooks State Kansas

Sec. 11 (Blk. Twp.) 10 (Sur. Rge.) 20W Map No.

Operator C & G Drlg.

Well No. 7 Farm Croffoot

Elev. 2238 Location NE SE SW

COMPLETE

990 Ft. From S Line SW

330 Ft. From E Line Quarter

1st. Report

Completion FEB 10 1954

Remarks

C & G Drlg. - Contr.

Spudding Date 12-19-53

Drlg. Data Oil well TD 3803

8" @ 167 Anhy 1688 Heeb. 3461

Tor. 3479 Lans. 3497 B KC 3715

Cong. 3745 ReArb. 3789 Arb. 3795

TD 3803 5" @ 3798 CO to 3803

S/ 15 bfph 50% wtr. Comp. 99 bopd 65% w

J. G. McGEHEE