


Section 11 Township 10 Range 20W

Well No. 8 Croffoot

Company C & G Drlg

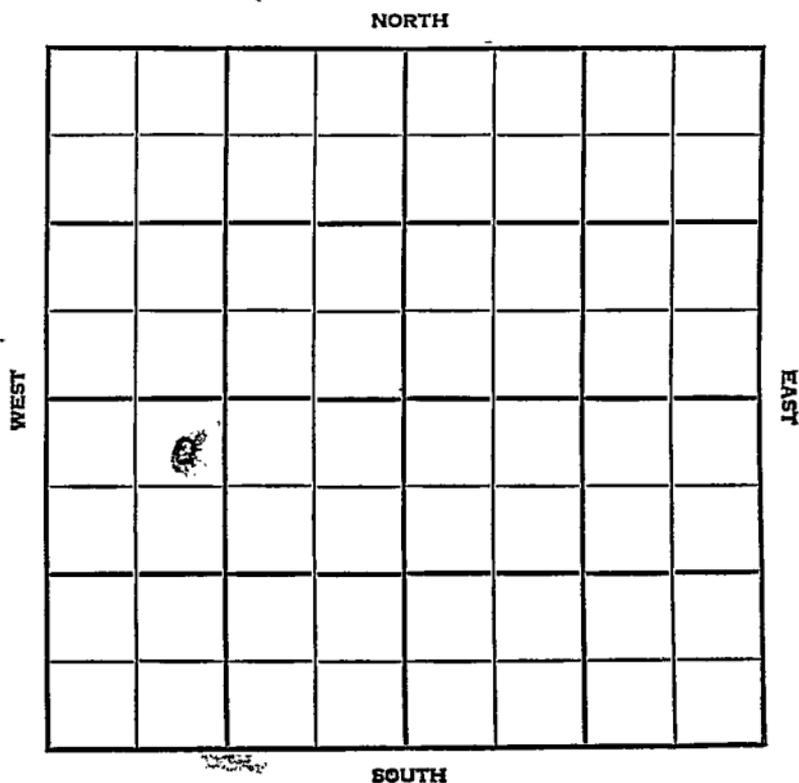

Rooks

Kansas

SEC.	TWP.	R.
11	10	20W


WELL NO. **8 Croffoot** FARM

COMPANY **C. & G. Drlg.**

CONTRACTOR **C. & G. Drlg. Contr.**

Marcotte Pool

330 _____ Ft. from N. Line
 _____ Ft. from S. Line
 _____ Ft. from E. Line
990 _____ Ft. from W. Line

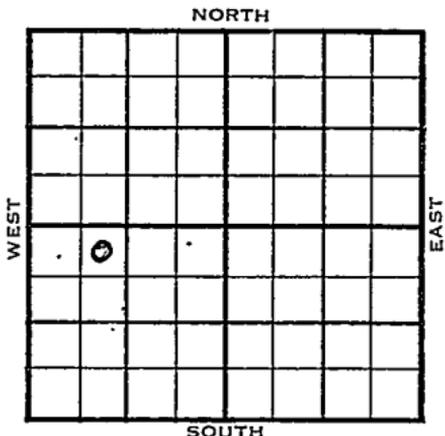

NE NW SW

1954	ELEVATION 2241'	REPORT
------	--------------------	--------

6/2 Spud 5-31-54
 8" @ 178 WOC

6/9 Heeb 3475' Tor 3495' L ans 3512'
 B KC 3725' Cong 3771' Simp 3785'
 Arb. 3813'
 Drlg.

8/4 Spud 5-31-54
 Oil Well
 TD 3817'
 8" @ 178'
 Heeb 3475'; Tor 3495'; L ans 3512';
 B KC 3725'; Cong 3771'; Simp 3785';
 Arb. 3813'
 TD 3817'
 5" @ 3814'
 CO to 3817', 2500A
 S/6 boph
 Comp. 23 bopd

COMPLETED

