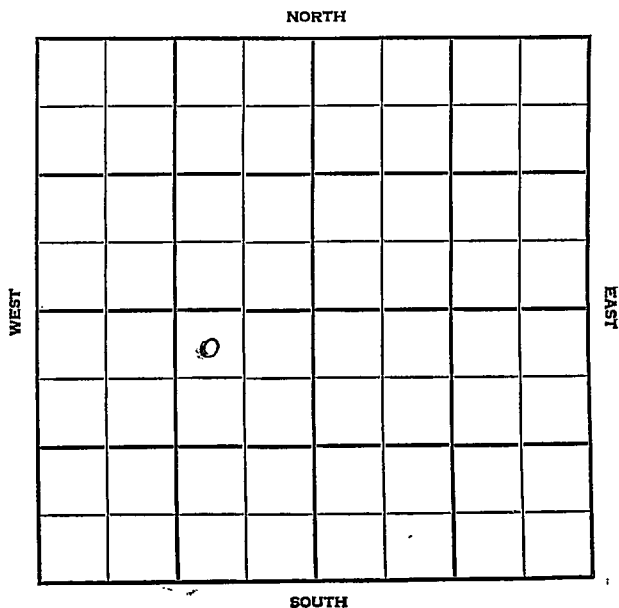


Section 11 Township 10 Range 20WWell No. #9 CrowfootCompany G & G Drlg.

Rooks

KANSAS

SEC.	TWP.	R.
11	10	20 W

WELL NO.

9 Crowfoot

FARM

COMPANY

C & G Drlg.

CONTRACTOR

Co. tools

Marcotte Pool

330 Ft. from N. Line

Ft. from S. Line

990 Ft. from E. Line

Ft. from W. Line

NW NE SW

NORTH

WEST

EAST

SOUTH

	ELEVATION	REPORT
1954	2238'	

10/27 Spud 10-24-54 8" @ 177 WOC

12/1 Spud 10-24-54 - Oil Well

TD 3788'

8" @ 177'

Anhy 1688', Heeb 3455', Tor 3475',

Lans 3492', B KC 3708', Cong. 3745',

Arb. 3783'

TD 3788'

5" @ 3785'

CO to 3788'

B/1/2 bo 500A


25 boph 10% wtr. 3 hrs.

Comp. 51 bopd

COMPLETED

FABEN GILSTRAP

County Rooks State Kansas
 Sec. 11 (Blk.) 10 (Sur.) 20W Map No.
 Operator C & G Drlg.
 Well No. 9 Farm Crowfoot
 Elev. 2238 Location NW NE SW

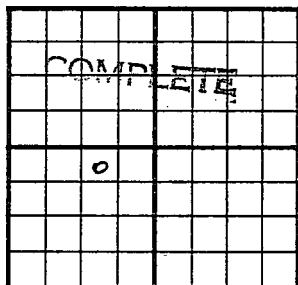

330 Ft. From N Line SW

990 Ft. From E Line Quarter

1st. Report

Completion DEC 1 1954

Remarks Marcotte Pool

Co. tools

Spudding Date 10-24-54

Drlg. Data Oil well TD 3788

8" @ 177 Anhy 1688 Heeb. 3455

Tor. 3475 Lans. 3492 B KC 3708

Cong. 3745 Arb. 3783 TD 3788

5" @ 3785 CO to 3788 B/ $\frac{1}{2}$ bo

500 A 25 boph 10% wtr. 3 hr.

Comp. 51 bopd

FABEN GILSTRAP