


SECTION 11 TOWNSHIP 10 S RANGE 20 W

WELL NO. # 8 Croffoot "A"

COMPANY I. O. Miller ^{5/2}

NORTH ~~SW~~ NE NE

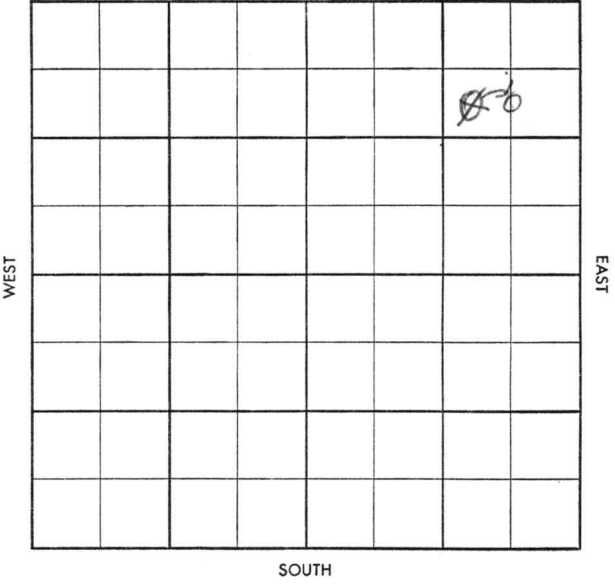

X
 Twp. _____ Pool _____
 GICK
 X

S-513-B

County Rooks Elev. _____
 Sec. 11 Twp. 10 Rge. 20W
 Company I. O. Miller
 Farm Name Croffoot "A" No. 8

TOPS	DEPTH	LOG	DATUM
Anh.			
Tp.			
H.			
Tr.			
Dg.			
B.L.			
L.			
K.C.			
B.K.C.			
Ce.			
C.			
M.			
M.			
K.			
Mz.			
Mq.			
V.			
S.			
S.			
A.			
R.			
Pf.			
G.			
T.D.			

Loc. in Sec. _____
SW NE NE
 Geol. _____
 Contr. _____
Wakefield
 Pool _____
Marcotte

JUL 23 1958
FIRST REPORT

Date Comm. 7-20-58
8" @ 250 drlg. 1695

Co. _____
 Lse. _____
 No. _____
 Sec. _____
 T. _____
 R. _____

Twp. ~~11~~ Pool ~~10~~

Co. ~~10~~ Face ~~10~~

CORRECTION

S-513-B

County Rooks Elev. 2231 DF
 Sec. 11 Twp. 10 Rge. 20W
 Company I. O. Miller
 Farm Name Croffoot "A" No. 8

TOPS	DEPTH	LOG	DATUM
Anh.			
Tp.			
H.	<u>3455</u>		
Tr.	<u>3478</u>		
Dg.			
B.L.			
L.	<u>3495</u>		
K.C.			
B.K.C.	<u>3711</u>		
Ce.			
C.	<u>3751</u>		
M.			
M.			
K.			
Mz.			
Mq.			
V.			
S.			
S.			
A.	<u>3838</u>		
R.			
Pf.			
G.			
T.D.	<u>3844</u>		

Loc. in Sec. SW NE NE
5/2

Geol. _____
 Contr. Wakefield
 Pool Marcotte



Date Comm. 7-20-58
8" @ 250 drlg. 1695 JUL 30 58 no log
on tests

D & A

Co.
Twp.
R.
Sec.
No.