
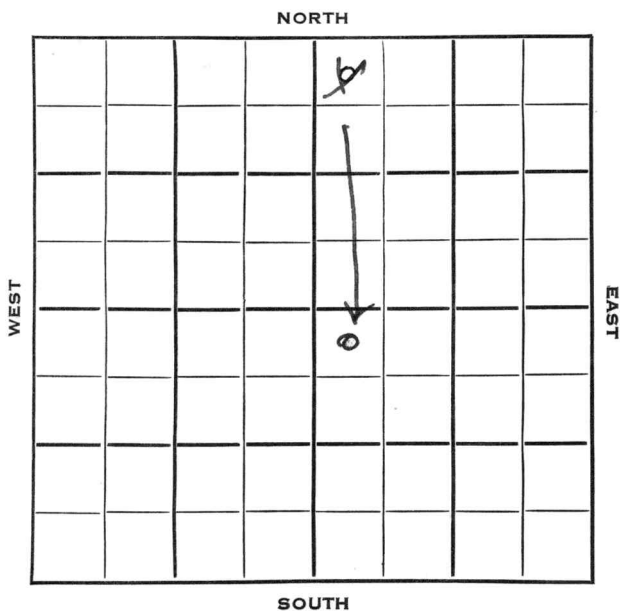


Section 11 Township 10 Range 20WWell No. #1 Croffoot "B"Company I. O. Miller

Sec. 11 Twp. 10 R. 20 WWell No. # 1 Croffoot "B" FarmI. O. Miller CompanyVirginia Drlg. Contractor
Marcotte Pool330 Ft. from N. Line Ft. from S. Line Ft. from E. Line330 Ft. from W. Line

NORTH

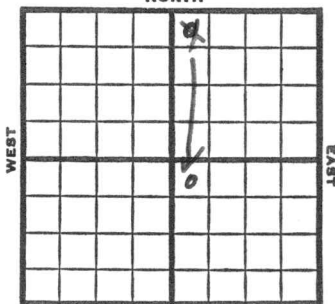

SOUTH

~~NW NW NE~~
NW NW SE

1953 Elev. 2227' REPORT

2/11 Spud 2-9-53

2/18 8" @ 210

Drlg. 3475'

2/26 RTD 3767' 5" @ 3765

3/12 NR

3/19 NR

3/25 Spud 2-9-53

Oil Well

TD 3770

8" @ 210

Top 3230, Heeb 3435, Tor 3456,

Lans 3472, B KC 3689, Cong

3723, Simp 3742, Arb 3763

TD 3767

5" @ 3765

DD 3770, 1000A

S/20 boph 3 hrs.

Comp. 3000 bopd

COMPLETED

County Rooks State KansasSec. 11 (Blk. 10) (Sur. 20W) (Twp.) Map No.Operator I. O. MillerWell No. 1 Farm Croffoot "B"Elev. Location NW NW NE

330 Ft. From N Line NE330 Ft. From W Line Quarter1st. Report FEB 11 1953

Completion

Remarks

Virginia Drlg. - Contr.Spudding Date 2-9-53

Drlg. Data

Marcotte Pool

J. G. McGEHEE

KANSAS

Map No. _____ Sec. 11 Twp. 10 R. 20WWell No. 1 Croffoot "B"I. O. Miller CompanyCORRECTION Contractor


NW NW SE

SECTION PLAT

330 Ft. from N. Line

_____ Ft. from S. Line

_____ Ft. from E. Line

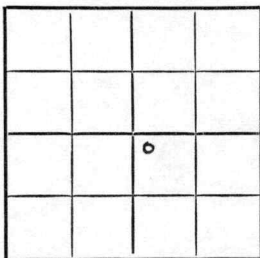330 Ft. from W. Line

Rooks County

RECORD

Location _____

Cased _____ in., _____ ft.

Rig up _____

Sand _____

Drilling and Remarks:

Gas _____

Oil _____

Total Depth _____

Reported

NW NW NE

PRODUCTION

1st 24 hrs. Nat. _____

1st 24 hrs. after shot _____

Gas _____ Cu. Ft.

Dry Hole _____

Abandoned _____

Date

FEB 11 1953 19


J. G. McGEHEE Scout

County _____ Rocks _____ State Kansas
 Sec. 11 (Blk. 10) (Sur. 20W) Map No. _____
 (Twp.) (Rge.)

Operator I. O. Miller

Well No. 1 Farm Croffoot "B"

Elev. 2227 Location NW NW SE

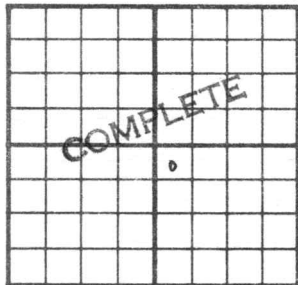

330 Ft. From N Line SE

330 Ft. From W Line Quarter

1st. Report

Completion MAR 25 1953

Remarks Marcotte Pool

Virginia Drlg. - Contr.

Spudding Date 2-9-53

Drlg. Data Oil well TD 3770

8" @ 210 Top. 3230 Heeb. 3435

Tor. 3456 Lans. 3472 B KC 3689

Cong. 3723 Simp. 3742 Arb. 3763

TD 3767 5" @ 3765 DD 3770 1000 A

S/ 20 boph 3 hr. Comp. 3000 bopd

J. G. McGEHEE