


Section 11 Township 10 Range 20W
Well No. #10 Croffoot
Company Cook & Galloway Drlg.

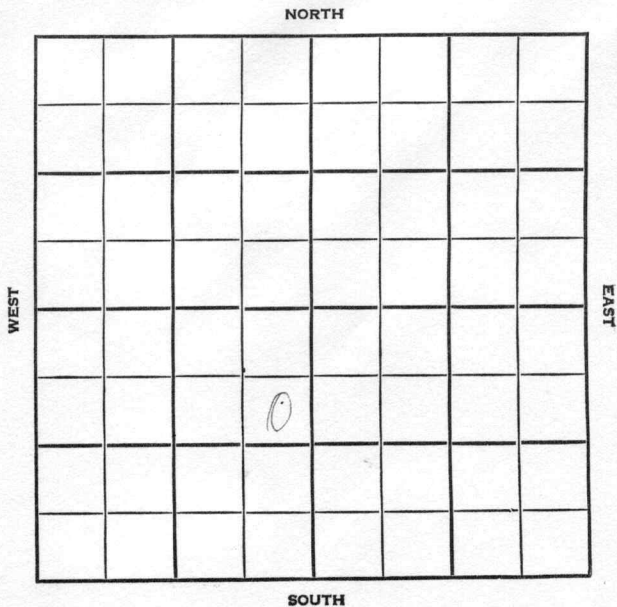

County Rooks Elev. _____
 Sec. 11 Twp. 10 Rgs. 20W
 Company Cook & Galloway Drlg.
 FarmName Croffoot No. 10

TOPS	DEPTH	LOG	DATUM	Loc. in Sec.
Anh.				SE NE SW
TP.				
H.				
Tr.				
Dg.				
Bl.				
L.				Geol. _____
K.C.				Contr. _____
B.K.C.				Co. tools _____
Ce.				
C.				Pool _____
M.				Marcotte
M.				
K.				
Mz.				
Me.				
V.				
S.				
S.				
A.				
R.				
PE.				
G.				
T.D.				

FIRST REPORT
 0
 JAN 9 '17

Date Comm. M I R

Co.
 L. Sec.
 No.
 Sec.
 T.
 R.

Co.

Use

No.

Sec.

T.

R.

County Rooks Elev. 2237
 Sec. 11 Twp. 10 Rgs. 20W
 Company Cook & Galloway Drlg.
 Farm Name Croffoot No. 10

TOPS	DEPTH	LOG	DATUM	Loc. in Sec.
Anh.	1676			SE NE SW
Tr.	3249			
H.	3454			
Tr.	3476			
Dg.				
Bl.				
L.	3492			
K.C.				Geol.
B.K.C.	3705			Contr.
Ce.				
C.	3739			Co. tools
M.				
M.				Pool <u>Glick</u>
K.				<u>Marcotte</u>
Mz.				
Me.				
V.				
S.	3754			
S.				
A.	3773			COMPLETE
R.				
PE.				
G.				
TD.	3777			

MAR 6 '57

o

Date Comm. MIR JAN 15 '57 1-9-57 858
174/165 @ 3250 JAN 23 '57 @ 3680
JAN 30 '57 DST 3274-85 1hr 100'
MSW BHP 980/20 9 1/2 3777
1125 WOCT FEB 6 '57 CO 3740 36/
3681-86 36/3700-86 \$ 1/2 Boph
15 \$ 10 Boph 5 hrs POT FEB 13 '57
FEB 20 '57 FEB 27 '57 Ph P. 146
Bopd + 1% wt 9.00 32°