


Section 11 Township 10 Range 20W

Well No. 3/2 Croffoot "A"

Company T. O. Miller

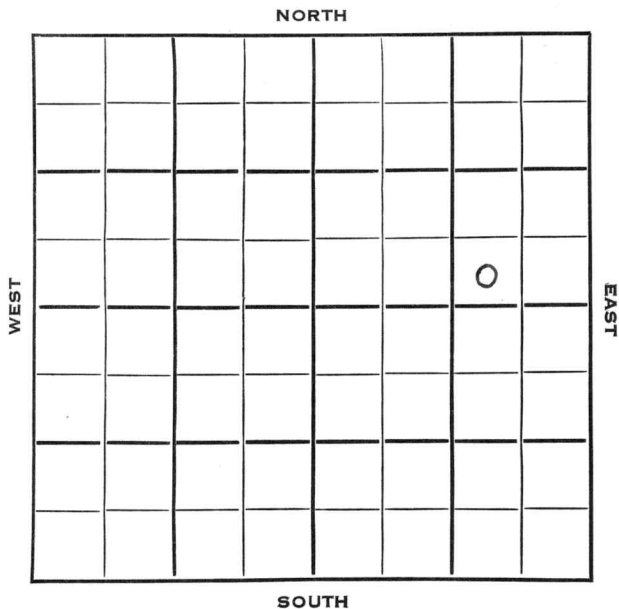

Rooks

KANSAS

SEC.	TWP.	R.
11	10	20 W ✓

WELL NO.

#3

#2 Croffoot "A"

FARM

COMPANY

I. O. Miller

CONTRACTOR

Virginia Drlg.

Marcotte Pool


_____ Ft. from N. Line

330 _____ Ft. from S. Line

990 _____ Ft. from E. Line

_____ Ft. from W. Line

SW SE NE

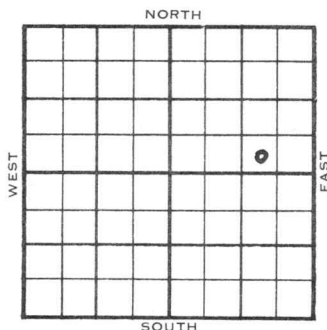

1953

ELEVATION

2231'

REPORT

12/9

Location

12/16

8" @ 209'

Anhy 1671'

Drlg. 3125'

1954

2/10

Spud 12-9-53 Oil well TD 3815

8" @ 209 Anhy 1671 Heeb 3456'

1" or. 3479 Lans 3493' B KC 3711

Cong. 3743' Simp. 3764' Arb. 3810'

DST 3811-15, open 1 hr rec 50' oil &


oily mud. 5' mud & wtr. 820#

TD 3815 5" @ 3810 CO to 3815

S/1 BOPH 4 hr. 250 A S/2 BOPH

Comp. 240 BOPD

COMPLETED

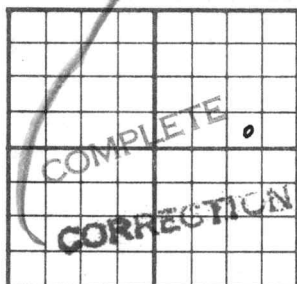County _____ Rooks _____ State KansasSec. 11 (Blk.) 10 (Sur. Rge.) 20W Map No. _____Operator I. O. MillerWell No. 3 Farm Croffoot "A"Elev. 2231 Location SW SE NE330 Ft. From S Line NE990 Ft. From E Line Quarter

1st. Report _____

Completion 10 10 1954Remarks Marcotte PoolVirginia Drlg. - Contr.Spudding Date 12-9-53Drlg. Data Oil well TD 38158" @ 209 Anhy 1671 Heeb. 3456Tor. 3479 Lans. 3493 B KC 3711Cong. 3743 Simp. 3764 Arb. 3810DST 3811-15 open 1 hr. Rec. 50' oil& oily mud 5' mud & wtr. 820#TD 3815 5" @ 3810 CO to 3815S/ 1 boph 4 hr. 250 A S/ 2 bophComp. 240 bopd