


DX 78-1

Rooks KANSAS

Section 11 Township 10 Range 20W
Well No. 4 Crowfoot "A"
Company I. O. Miller

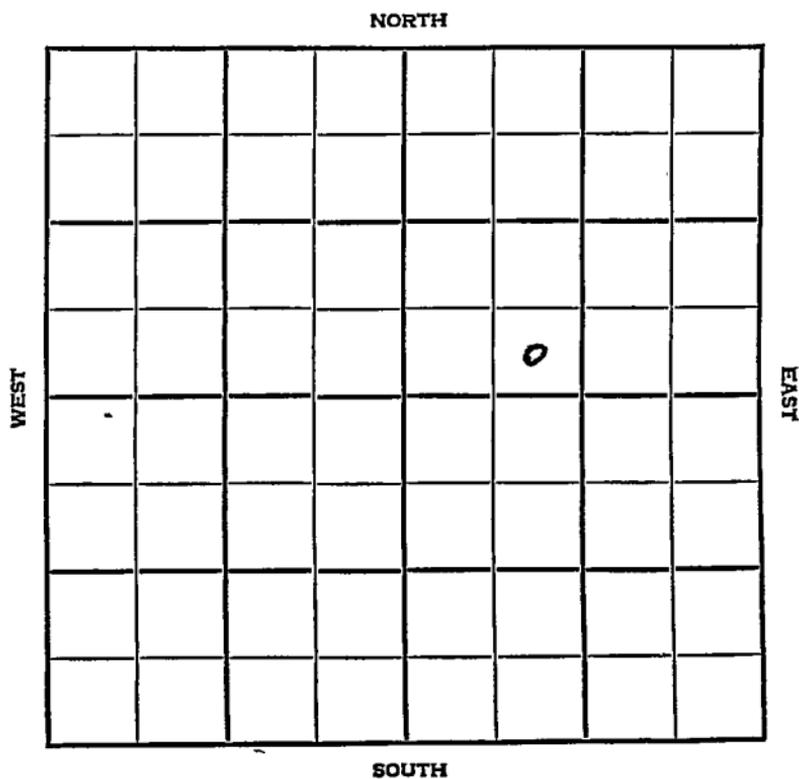

Rooks

KANSAS

SEC.	TWP.	R.
11	10	20 W

WELL NO. # 4 Crowfood "A" FARM

COMPANY I. O. Miller

CONTRACTOR Virginia

Marcotte Pool


_____ Ft. from N. Line

330 _____ Ft. from S. Line

_____ Ft. from E. Line

990 _____ Ft. from W. Line.

SE SW NE

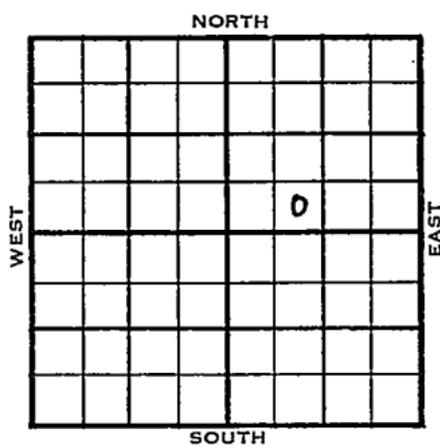

	ELEVATION	REPORT
1955	2229'	

1/5 MIR
 3/2 Spud 1-4-55
 Oil Well
 TD 3790'
 8" @ 222'
 Anhy 1668' Heeb. 3449' Tor. 3471' Lans
 3486', Arb. 3787'
 TD 3789'
 5" @ 3787'
 DD 3790'
 S/ 2 1/2 boph 500 A S/ 12 boph 8 hr.
 Comp 213 bopd.

COMPLETED

