


Section 11 Township 10 Range 20W

Well No. #5 Crowfoot "A"

Company I.O. Miller

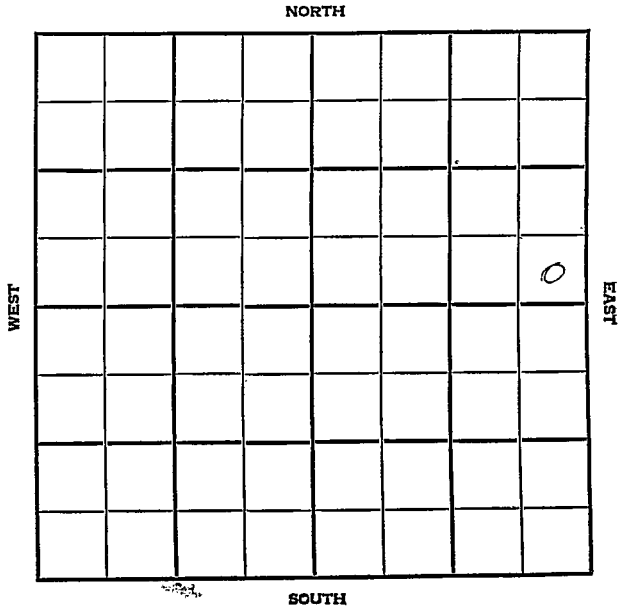

County Rooks Elevation 10  
 Sec. 17 Twp. 10 Rgs. 20W  
 Company A. O. Miller  
 Farm Name Crowfoot "A" No. 5

TOPS	DEPTH	LOG	DATUM
Anh.			
Tr.			
H.			
Tr.			
Dg.			
Bl.			
L.			
K.C.			
B.K.C.			
Ce.			
C.			
M.			
M.			
K.			
Mz.			
Ma.			
V.			
S.			
S.			
A.			
R.			
PE.			
G.			
T.D.			

Loc. in Sec. SE SE NE  
 Geol. \_\_\_\_\_  
 Contr. Virginia Drlg  
 Pool Marcotte

		0

Date Comm. 9-16-56 **FIRST REPORT**  
8" @ 220 w/ 125, Drlg. 1754 OCT 10 56

12.51

Co.  
 1754  
 No.  
 Sec.  
 T.  
 R.

County Rooks Elev. 2229  
 Sec. 11 Twp. 10 Rge. 206  
 Company I. O. Miller  
 Farm Name Crowfoot "A" No. 5

TOPS	DEPTH	LOG.	DATUM	Loc. in Sec.
Anb.				SE SE NE
Tr.				
H.	3447			
Tr.	3471			
Dg.				
Bl.				
L.	3487			
K.C.				Geol.
B.K.C.	3697			Contr.
Ce.				
C.	3726			Virginia Drl
M.				
M.				Pool
K.				Marcotte
Mz.				
Mo.				
V.				
S.	3752			
S.				
A.	3772			
R.				
PE.				
G.				COMPLETE
TR.	3779			

Date Comm. 9-16-56  
 8" @ 220 w/ 125, Drlg. 1754 @ 17'56

DST 3531-62 30" 15' Md FP  
 O BHP 1125/15" @ 3640 OCT 24 56  
 DST 3609-62 up 1 hr rec 30'  
 O spud Md BHP 150/15 DST  
 3774-78 up 1 hr rec 700' oil  
 + 50' Md oil 600/15" 5 1/2  
 @ 3774/575 co. 3779 \$ 10  
 Both not w 10 hrs/12" \$ 13 Both

noted 2 hrs OCT 31 '56 NOV 7 '56 NOV 13 '56

Ph P. 177 Bopd noted 9 rows  
28°

11-10-20

se se ne