


Section 11 Township 10 Range 20 W

Well No. # 3 Crowfoot "B"

Company L. O. Miller

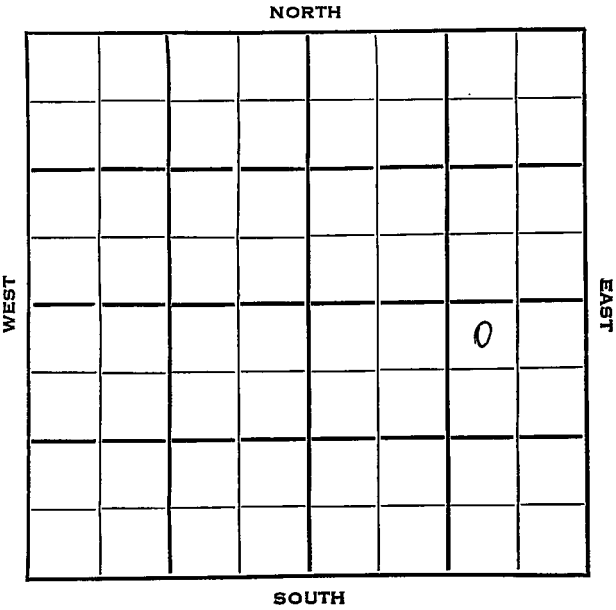

Rooks

KANSAS

SEC.	TWP.	R.
11	10	20 W

WELL NO.

3 Crowfoot "BW

FARM

COMPANY

I. O. Miller

CONTRACTOR

Virginia Drlg.

Marcotte Pool


330 Ft. from N. Line

Ft. from S. Line

990 Ft. from E. Line

Ft. from W. Line

NW NE SE

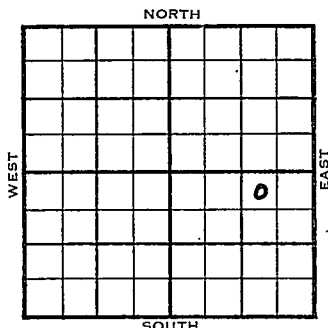

	ELEVATION	REPORT
1953	2227'	

12/2	Spud 11-30-53	
12/16	KC 3480', Arb. 3779'	
	RTD 3780'	
	5" @ 3779'	
1954		
1/6	DD 3781' TD 500 A S/62 BO 1 hr.	
	POP	
1/13	NR	
1/20	NR	
2/10	Spud 11-30-53 Oil well TD 3781	
	8" @ 212 Heeb 3440 Tor. 3466	
	KC 3480 B KC 3698 Arb. 3 779	
	TD 3780 5" @ 3779 DD 3781	
	500 A S/62 BO 1 hr.	
	Comp. 3000 BOPD	

COMPLETED

County Rooks State Kansas

Sec. 77 (Blk. 10 (Sur. 20W Map No. _____
Twp.) Rge.)

Operator T. O. Miller

Well No. 3 Farm Crowfoot "B"

Elev.	Location	NW	NE	SE
-------	----------	----	----	----

FIRST REPORT

330 Ft. From N Line SE

990 Ft. From F Line Quarter

1st. Report DEC 2 1953

Completion


Remarks

Virginia Drlg. - Contr.

Spudding Date **11-30-53**

Drig. Data Marcotte Pool

County _____ Rooks _____ State Kansas
 Sec. 11 (Blk. 10) (Sur. 20W) Map No. _____
 Operator I. O. Miller
 Well No. 3 Farm Croffoot "B"
 Elev. 2227 Location NW NE SE

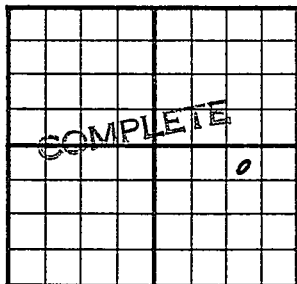

330 Ft. From N Line SE
990 Ft. From E Line Quarter
 Ist. Report _____
 Completion FEB 10 1954
 Remarks Marcotte Pool
Virginia Drlg. - Contr.
 Spudding Date 11-30-53

Drlg. Data Oil well TD 3781
8" @ 212 Heeb. 3440 Tor. 3466
KC 3480 B KC 3698 Arb. 3779 TD 3780
5" @ 3779 DD 3781 500 A S/ 62 bo 1 hr.
Comp. 3000 bopd

J. G. McGEHEE