Rooks KANSAS

SECTION 11 TOWNSHIP 10 RANGE 20W

WELL NO. #8 Crowfoot "B"

COMPANY I.O. Miller

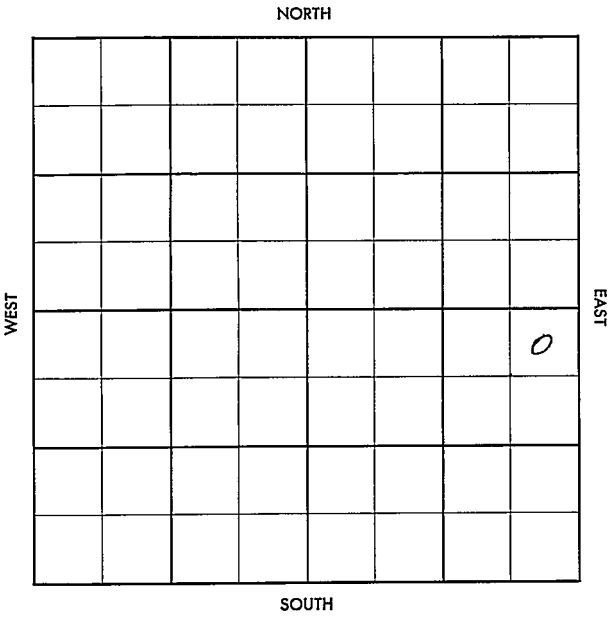

FORM 504-3 SUNRAY

FORM 513 SUNRAY

County Rooks Elev.

Sec. 11 Twp. 10 Rge. 20W

Company T. O. Miller

FarmName Crowfoot "B" No. 8

TOPS	DEPTH	LOG	DATUM
Anh.			
Tp.			
H.			
Tr.			
Dg.			
Bl.			
L.			
K.C.			
B.K.C.			
Ce.			
C.			
M.			
M.			
K.			
Mz.			
Mo.			
V.			
S.			
S.			
A			
R.			
P€.			
G.			
T.D.			

Loc. in Sec. NE NE SE

Geol.

Contr. Virginia

Lse.

Pool Marcotte

FIRST REPORT

No.

Sec.

T.

R.

Date Comm.

Location SEP 26 '56

X

FORM 513 SUNRAY

County Rooks Elev.

Sec. 11 Twp. 10 Rge. 20W

Company T. C. Miller

FarmName Crowfoot "B" No. 8

TOPS	DEPTH	LOG	DATUM
Anh.	1664		
Tp.			
H.	3443		
Tr.	3466		
Dg.			
Bl.			
L.	3482		
K.C.			
B.K.C.			
Ce.			
C.			
M.			
M.			
K.			
Mz.			
Me.			
V.			
S.			
S.			
A	3777		
R.			
P.C.			
G.			
T.D.	3782		

Loc. in Sec. NE NE SE

Geol.

Contr. Virginia

Pool Marcotte

COMPLETE

NOV 15 '56

Date Comm.

Location SEP 26 '56 X Spd 9-19-56 8 5/8 @ 215/125 Anhy 1664 Ø 2900 OCT 3 '56 DST 3520-50 1hr rec 30' Md (550) BHP 810 DST 3621-60 30" 15' Md. BHP 130 DST 3666-3705 1hr rec 70' OCM BHP 825# DST 3778-82 1hr rec 630' gssy oil BHP 550. 5 1/2 @ 3778/125 OCT 10 '56 CO 3782 1/2

Co. Lse. No. Sec. T. R.

FORM 513-1 SUNRAY

$ 8 Bopd + 10% wtr 12 hrs
Thru $ 14½ Dopd + 12% wtr
16 hrs Pot OCT 17 '56 P. 70 Bopd
+ 14% wtr OCT 24 '56 OCT 31 '56 NOV 7 '56
NOV 13 '56 Ph P. 157. Bopd
12% wtr

11-10-20