


Section 11 Township 10 Range 20W

Well No. #9 Crowfoot "B"

Company T.O. Miller

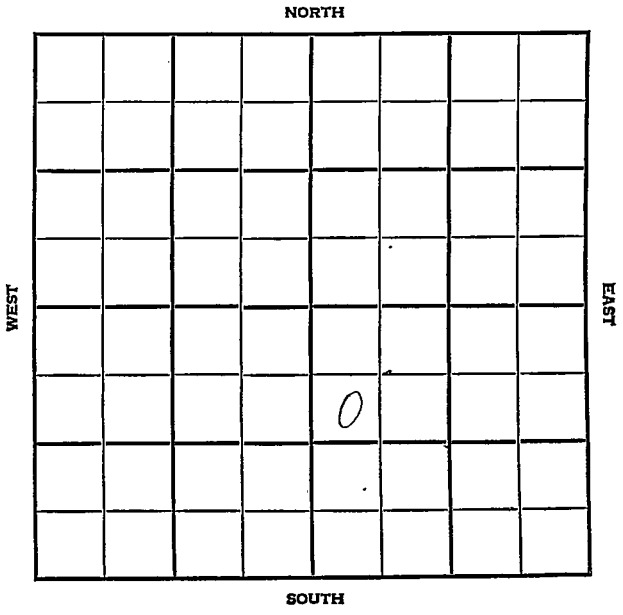

County Rooks Elev. \_\_\_\_\_  
 Sec. 11 Twp. 10 Rge. 20W  
 Company T. O. Miller  
 Farm Name Crowfoot No. 9

TOPS	DEPTH	LOG	DATUM
Anh.			
Tp.			
H.			
Tr.			
Dg.			
Bl.			
L.			
K.C.			
B.K.C.			
Ce.			
C.			
M.			
M.			
K.			
Mz.			
Ma.			
V.			
S.			
S.			
A.			
R.			
PE.			
G.			
T.D.			

Loc. in Sec. \_\_\_\_\_  
SW NW SE  
 Geol. \_\_\_\_\_  
 Contr. \_\_\_\_\_  
Virginiae Drlg  
Pool  
Marquette  
**FIRST REPORT**  
 OCT 24 '56  
6

Date Comm. spd. 10-20-56  
8" @ 228 w/125, Drlg. 2195

888 T S VAN

5.7

Co.  
Lsec  
No.  
Sec.  
T.  
R.

County Rooks Elev. \_\_\_\_\_  
 Sec. 11 Twp. 10 Rge. 20W  
 Company I. G. Miller  
 Farm Name Crowfoot "B" No. 9

TOPS	DEPTH	LOG	DATUM	Loc. in Sec.
Anh.				SW NW SE
Tp.				
H.	3444			
Tr.	3467			
Dg.				
Bl.				
L.	3485			Geol. _____
K.C.				Contr. _____
R.K.C.	3702			
Ce.				
C.	3732			Virginia Drlg.
M.				
M.				Pool
K.				Marcotte
Mz.				
Mo.				
V.				
S.	3754			<b>COMPLETE</b>
S.				
A.	3774			
R.				
PE.				
G.				
TD.	3790	<del>3789</del>		

Date Comm. spd. 10-20-56

8" @ 223 w/125. Drlg. 2195 OCT 31 '56  
 # 3700 NOV 7 '56 DST 3610 - 66 1hr  
 rec 230' OCM BHP 925 / 25"  
 DST 3666 - 3700 up 1hr rec 570'  
 OCM FPD - 190 BHP 975 / 25"  
 Lost circ. @ 3696 DST 3775 - 90  
 up 1hr rec 85' HOCM BHP 240 / 20  
 5 1/2 @ 3775 co DD 3794 @ 3785  
 1 Boph 25 1/2 wto PB 3750 23 /

3691-96 \$ 20 Goph notw

8/3679-81 12/3672-75 \$

28 Goph. 16 AM PFIS \$

12 Boph notw Pop NOV 13 '56 NOV 21 '56

NOV 28 '56

DEC 5 '56

DEC 12 '56

Ph P

708 Bopd notw gran 31°

11-10-20w

sw nu se