

Rooks

DX 78-1


KANSAS

Section 11 Township 10 Range 20W

Well No. #5 Crowfoot "C"

Company I.O. Miller

NORTH

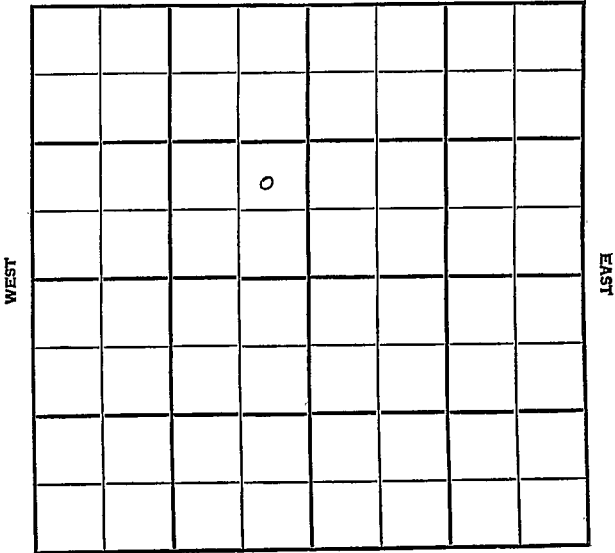

SOUTH

Rooks KANSAS


SEC.	TWP.	R.
11	10	20 W

WELL NO. # 5 Crowfoot "C" FARM

COMPANY I. O. Miller

CONTRACTOR Virginia Drlg.
Marcotte Pool

_____ Ft. from N. Line
 990 _____ Ft. from S. Line
 330 _____ Ft. from E. Line
 _____ Ft. from W. Line

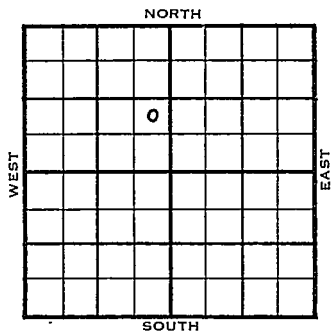

NE SE NW

	ELEVATION	REPORT
1954	2235'	

9/1 Spud 8-25-54
 8" @ 222 Anhy 1685'

9/22 Drlg. 3230'
 Spud 8-25-54 SWD well
 TD 4110 8" @ 222 Anhy 1685
 Heeb 3474 Tor. 3495 Lans 3510
 B KC 3728 Cong. 3777 Arb. 3844
 TD 4110 5" @ 4004 CO to 4110
 Comp. SWD well

ABANDONED

County **Rooks** State **Kansas**

Sec. **11** (Blk. Twp.) **10** (Sur. Rge.) **20W** Map No.

Operator **I. O. Miller**

Well No. **5** Farm **Crowfoot "C"**

Elev. Location **NE SE NW**

990 Ft. From **S** Line **NW**

330 Ft. From **E** Line Quarter

1st. Report **SEP 1 1954**

Completion

Remarks

Virginia Drlg. - Contr.

Spudding Date **8-25-54**

Drlg. Data **Marcotte Pool**

8" @ 222 Anhy 1685 drlg. 3230

FABEN GILSTRAP

