


DX 78-1

Section 11 Township 10 Range 20W

Well No. 3 Croffoot "C"

Company T. O. Miller

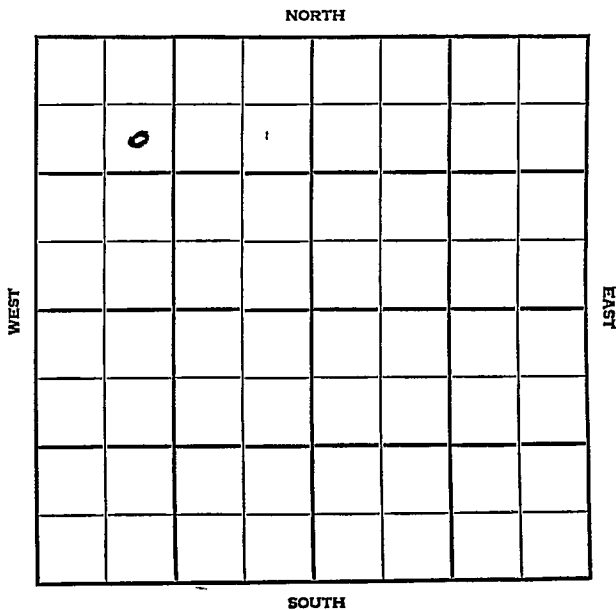

Rooks

KANSAS

SEC.	TWP.	R.
11	10	20W ✓

WELL NO.

3 Croffoot "C"

FARM

COMPANY

I. O. Miller

CONTRACTOR

Virginia Drlg.


Marcotte Pool

990 Ft. from N. Line

Ft. from S. Line

Ft. from E. Line

990 Ft. from W. Line

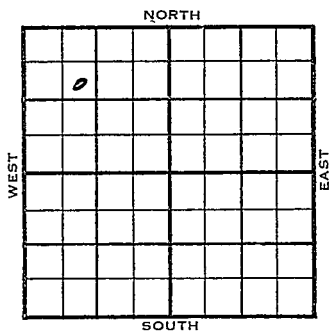

SE NW NW

1954

ELEVATION

-

REPORT

6/8

Spudding 6-5-54

8" @ 198

Drlg. 2290

6/15

Spud 6-5-54

D&amp;A

TD 3865'

8" @ 198'

Heeb 3495', Tor 3518', Lans 3532',

B KC 3574', Cong 3802', Simp 3835',

Arb. 3846'

TD 3865'

D&amp;A

ABANDONED



