
DX 78-1

Rooks KANSAS

Section 11 Township 10 Range 20 W

Well No. # 4 Crowfoot "C"

Company T. O. Miller

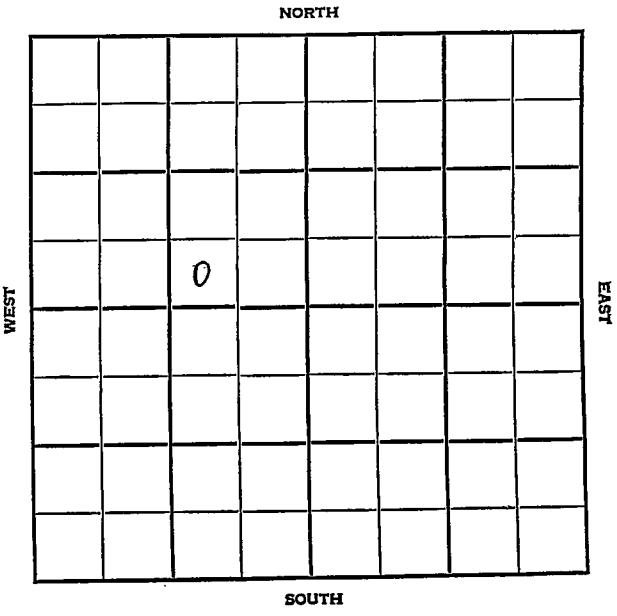

Rooks KANSAS

SEC.	TWP.	R.
11	10	20W

WELL NO.

4 Crowfoot "C" FARM

COMPANY

I. O.Miller

CONTRACTOR


Virginia Drlg.

_____ Ft. from N. Line

330 Ft. from S. Line

990 Ft. from E. Line

_____ Ft. from W. Line

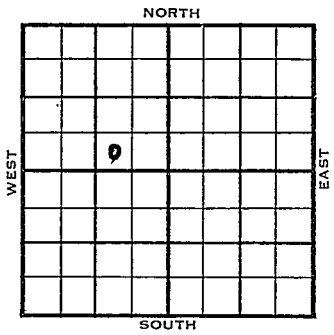

SW SE NW

1954	ELEVATION 2239'	REPORT
8/18	Spud 8-13-54 8" @ 210' Drlg. 2650'	
10/27	Spud 8-13-54 - Oil Well TD 3798' 8" @ 210' Anhy 1690', Top 3256', Heeb 3460', Tor 3482', KC 3496', B KC 3719', Cong ~~3449~~ 3749', Simp. 3765', Arb. 3793' TD 3796' 5" @ 3794' DD 3798' S/6 boph Comp. 186 bopd	

COMPLETED

DX-78

FORM 275 FOR SALE BY KANSAS BLUE PRINT CO.


County Rooks State Kansas

Sec. 11 (Blk. Twp.) 10 (Sur. Rge.) 20W Map No.

Operator I. O. Miller

Well No. 4 Farm Crowfoot "C"

Elev. 2239 Location SW SE NW

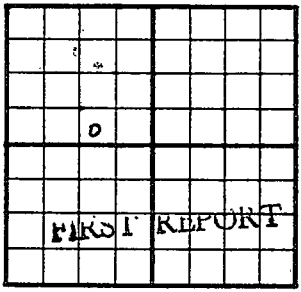

330 Ft. From S Line NW Quarter

990 Ft. From E Line

1st. Report AUG 18 1954

Completion

Remarks Virginia Drlg. - Contr.

Spudding Date 8-13-54

Drlg. Data

8" @ 210 drlg. 2650

FABEN GILSTRAP

FORM 275 FOR SALE BY KANSAS BLUE PRINT CO.


County Rooks State Kansas

Sec. 11 (Blk. Twp.) 10 (Sur. Rge.) 20W Map No.

Operator I. O. Miller

Well No. 4 Farm Crowfoot "C"

Elev. 2239 Location SW SE NW

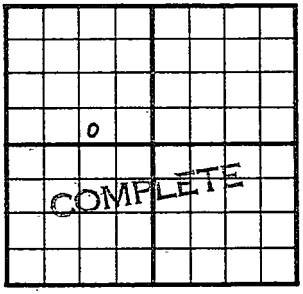

330 Ft. From S Line NW

990 Ft. From E Line Quarter

1st. Report

Completion OCT 27 1954

Remarks

Virginia Drlg. - Contr.

Spudding Date 8-23-54

Drlg. Data Oil well TD 3798

8" @ 210 Anhy 1690 Top. 3256

Heeb. 3460 Tor. 3482 KC 3496 B KC 3719

Cong. 3749 Simp. 3765 Arb. 3793

TD 3796 5" @ 3794 DD 3798 S/ 6 boph

Comp. 186 bopd.

FABEN GILSTRAP