


Section 11 Township 10 Range 21W

Well No. #2 DeYoung

Company Cities Service

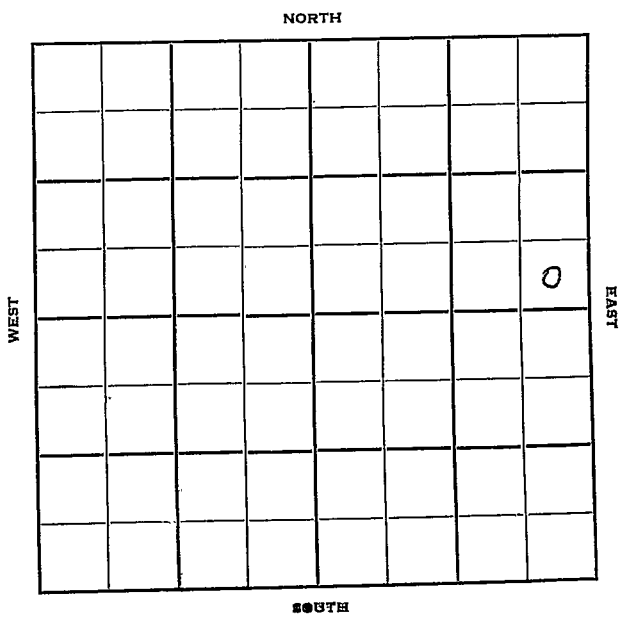

Sec. 11 Twp. 10 R. 21-W

Well No. #2 DeYoung Farm

Cities Service Company

Bass Contractor


_____ Ft. from N. Line

330 Ft. from S. Line

330 Ft. from E. Line

_____ Ft. from W. Line

SE SE NE

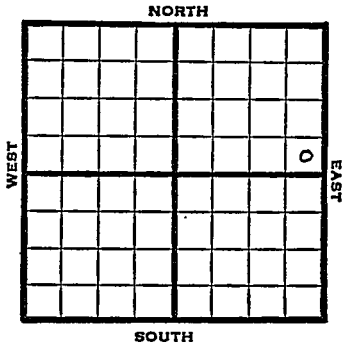

1950 Elev 2266 REPORT

8/30 Location
 9/20 Spud 9-3-50
 8" @ 204
 Heeb 3495
 KC 3533
 Simp 3849
 TD 3895
 D&A

Dodge 3514
 Cong 3805
 Arb 3863-95 TD

ABANDONED

