


Section 11 Township 10 Range 21WWell No. 3 DeYoungCompany Jones Shelburne & Farmer

NORTH

WEST

EAST

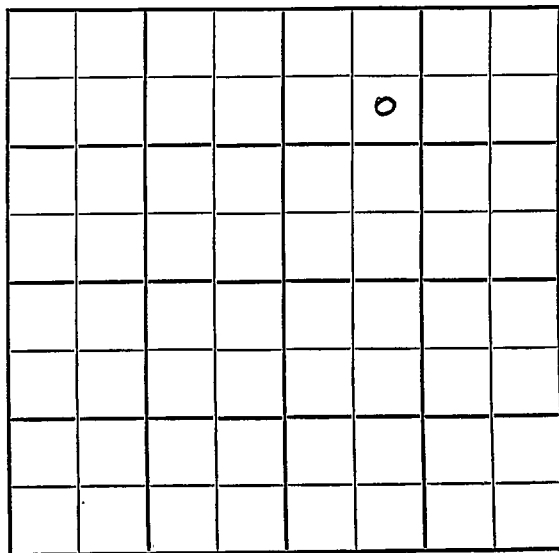

SOUTH

Graham KANSAS

SEC. <u>11</u>	TWP. <u>10</u>	R. <u>21W</u> ✓
----------------	----------------	-----------------

WELL NO. _____

3 DeYoung FARM

COMPANY

Jones, Shelburne & Farmer

CONTRACTOR


J-S-F

990 _____ Ft. from N. Line

_____ Ft. from S. Line

_____ Ft. from E. Line

990 _____ Ft. from W. Line

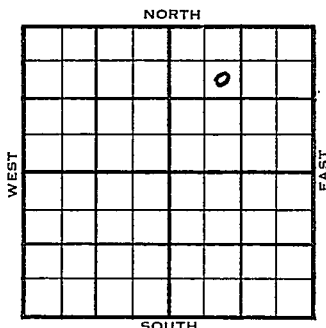

SE NW NE

	ELEVATION	REPORT
<u>1954</u>	<u>2274'</u>	

7/7	Location
7/21	Heeb 3488' Lans 3526 Arb. 3842 RTD 3846 5" @ 3842

8/18	Spud 7-8-54 Oil Well TD 3846' 8" @ 151' Heeb 3488', Lans 3526', Arb. 3842' TD 3846' 5" @ 3842' CO to 3846', 1½ boph 3000A S/20 boph Comp. 158 BOPD
------	---

COMPLETED

County **Graham** State **Kansas**

Sec. **11** (Blk. Twp.) **10** (Sur. Rge.) **21W** Map No.

Operator **Jones, Shelburne & Farmer**

Well No. **3** Farm **DeYoung**

Elev.	Location	SE	NW	NE
-------	----------	----	----	----

0

FIRST REPORT

990 Ft. From **N** Line **NE**

990 Ft. From W Line Quarter

1st. Report JUL 7 1954

Completion

Remarks

J-S-F - Contr.

Spudding Date .. .

Drq. Data

Location

J. G. McGEHEE

FABEN GILSTRAP