


DX 78-1 Graham

KANSAS

Section 11 Township 10 Range 21W

Well No. #1 DeYoung "B"

Company Jones, Shelburne & Farmer

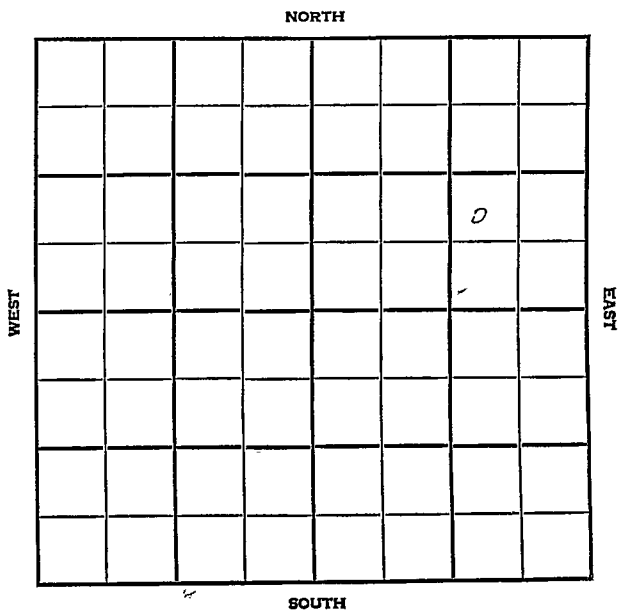

Graham KANSAS

SEC.	TWP.	R.
11	10	21W

WELL NO.

1 DeYoung "B"

FARM

COMPANY

Jones, Shelburne & Farmer

CONTRACTOR

Co. Tools


Cooper Pool

_____ Ft. from N. Line

990 _____ Ft. from S. Line

990 _____ Ft. from E. Line

_____ Ft. from W. Line

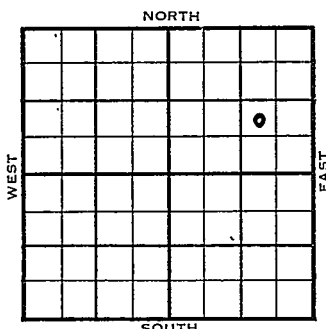

NW SE NE

	ELEVATION	REPORT
1954	2261'	

11/17 Spud 11-9-54
8" @ 151'
rlg. 3640'

11/23 Spud 11-9-54 D & A TD 3861
8" @ 151 Anhy 1743 Heeb 3492
Lans. 3529
DST 3713-46 open 15 min, rec 30' mud
900# B KC 3754 Arb. 3846
TD 3861' D & A

ABANDONED

FABEN GILSTRAD

County Graham State Kansas
 Sec. 11 (Blk. Twp.) 10 (Sur. Rge.) 21W Map No.
 Operator Jones, Shelburne & Farmer
 Well No. 1 Farm DeYoung "B"
 Elev. 2261 Location NW SE NE

990 Ft. From S Line NE990 Ft. From E Line Quarter

1st. Report

Completion NOV 23 1954

Remarks Cooper Pool
Co. tools

Spudding Date 11-9-54Drilg. Data D & A TD 38618" @ 151 Anhy 1743 Heeb. 3492Lans. 3529 DST 3713-46 open 15 min.Rec. 30' mud 900# B KC 3754 Arb. 3846TD 3861D & A

FABEN GILSTEDT