


Section 11 Township 10 Range 21 WWell No. #1 DeYoung "C"Company Jones, Shelburne & Farmer

NORTH

WEST

EAST

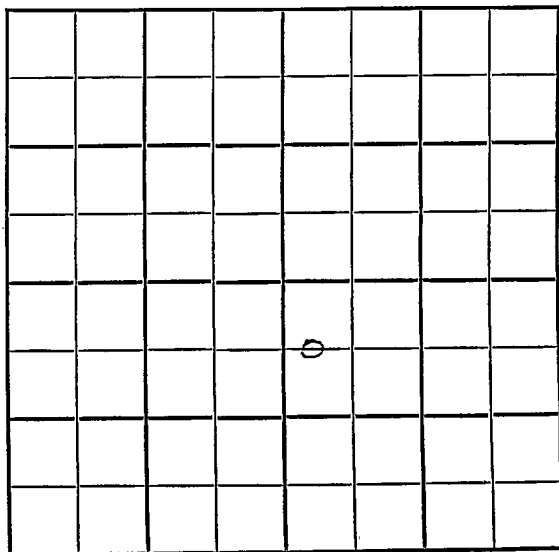

SOUTH

Graham

KANSAS

SEC.	TWP.	R.
11	10	21W

WELL NO.

#4 DeYoung ### "C"

FARM

COMPANY

Jones, Shelburne & Farmer

CONTRACTOR

Co. Tools


Cooper

_____ Ft. from N. Line

_____ Ft. from S. Line

_____ Ft. from E. Line

_____ Ft. from W. Line

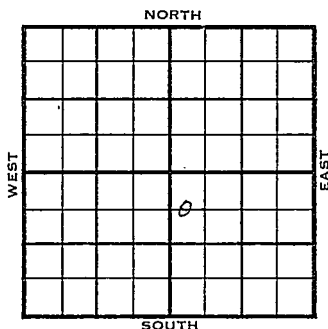C $W\frac{1}{2}$ NW SE

1956	ELEVATION	REPORT
	2216	
2-15	Comm. 2-6-56 ### 8" @ 164 Drlg. 2175' Anh. 1691	
4-11	DST 3783-87 op 1 hr. rec. 420' free oil 30' o&gcm, 800/20" 5 $\frac{1}{2}$ " @ 3784 CO to 3787 S/ 1 boph, 4 hrs., 500 A S/ 12 $\frac{1}{2}$ boph 8 hr. Comp. 132 bopd H. 3440 Tr. 3465 L. 3483 A. 3783 TD 3787'	

COMPLETED

County Graham Elev. 2216Sec. 11 Twp. 20 Rge. 21WCompany Jones, Sherburne & FarmerFarmName DeYoung "C" No. 4

TOPS	DEPTH	LOG	DATUM	Loc. in Sec.
Anh.	<u>1591</u>			<u>C W $\frac{1}{2}$ NW SE</u>
Tr.				
Dg.				
Bl.				
L.				
K.C.				Geol.
B.K.C.				Contr.
Ce.				<u>Co. tools</u>
C.				
M.				Pool
M.				<u>Cooper</u>
K.				
Mz.				
Mq.				
V.				
S.				
S.				
A.				
R.				
PE.				
G.				
T.D.				

FIRST REPORT

FEB 15 '56

Date Comm. 2-6-56 CSO - FO8" @ 164 drlg. 2175

County Graham Elev. 2216
 Sec. 11 Twp. 170 Rge. 21W
 Company Jones, Shelburne & Farmer
 Farm Name DeYoung "C" No. 4

TOPS

DEPTH

LOG

DATUM

Loc. in Sec.

Anh.	1691			C W $\frac{1}{2}$ NW SE
TP.				
H.	3440			
Tr.	346.5			
Dg.				
BL.				
L.	348.3		1267	Geol.
K.C.				Contr.
B.K.C.				Co. tools
Ce.				Pool
C.				Cooper
M.				COMPLETE
M.				
K.				
Mz.				
Me.				
V.				
S.				
S.				
A.	378.3		1567	
R.				
PE.				
G.				
T.D.	3787			

Date Comm. 2-6-56

APR 11 1956

8" @ 164 DST 3783-87 open 1 hr.

rec. 420' free oil 30' o & gcm 800/20"

5 $\frac{1}{2}$ " @ 3784 CO to 3787 S/ 1 boph1 hr. 500 A S/ 12 $\frac{1}{2}$ boph 8 hr.

Comp. 132 bopd